

Name

Service No.

Address 82 SHADE ST

Location

Kind of Pipe

Size

Size of Main

Repair—Renewal—New Service

RUGGERI CONST

Location


| Date | Material | Amount | Total | Date | Amount |
|---------|-------------|--------|-------|------|--------|
| 9/16/98 | 172' 6" PVC | | | | |
| | 1 CLEAN OUT | | | | |
| | 5' 4" | | | | |
| | SADDLE | | | | |
| | NIPPER | | | | |
| | 90° EL | | | | |
| | | | | | |
| | | | | | |
DATE

TOWN OF LEXINGTON — BOARD OF PUBLIC WORKS

SEWER DIVISION

Sketch of Service Here

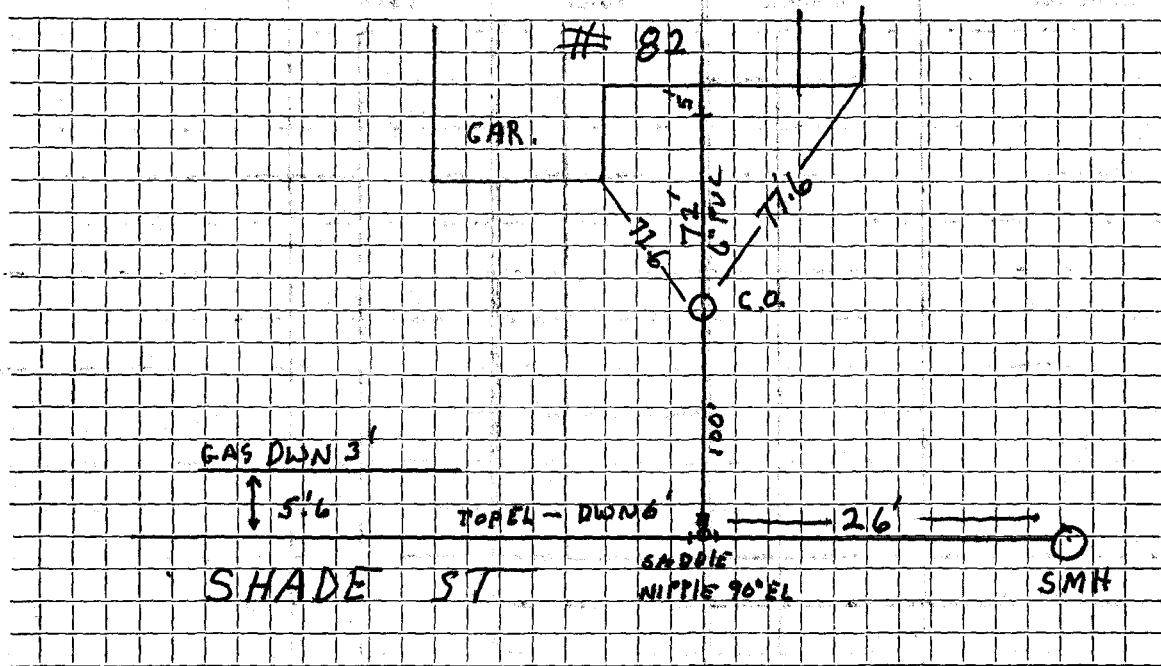

Connection made in SHADE ST Street. Work completed

Remarks: WATER SEWER 10' APART AT C.O. D.T.