



Name Leo McSweeney

Service No. 58

Address #84 Shade St.

84 Shade Street

Location

Kind of Pipe

Size 6"

Size of Main 8"

~~Repair/ Renewal~~ — New Service W.O. #3437. Valeri Permit #2715.

Location NOV 24 1976

Date	Material	Amount	Total	Date	Amount
	Owner supplied own 6" pipe & fittings			6-11-75	350.00
6-23-75	Labor	97.34		11-24-75	136.94
	10% O.H.	9.73	\$107.07		213.23
1	22 1/2° Bend		9.52		
1	11 1/2° Elbow		3.94		
1	Hr. Trucking		3.00		
1	Hr. Pickup		1.50		
2	Hrs. Backhoe	@6.50	13.00		
1	Hr. Compressor		5.00		
1	Patch 15' x 7'		70.00		
6/25/75	149' 6" Transite pipe		\$213.03		
	15' 4" Cast Iron Pipe				
				Feb 278	ROCKS 48' out from manhole
				12-22-97	45-48'


DATE \_\_\_\_\_

TOWN OF LEXINGTON — BOARD OF PUBLIC WORKS

SEWER DIVISION

Sketch of Service Here

84

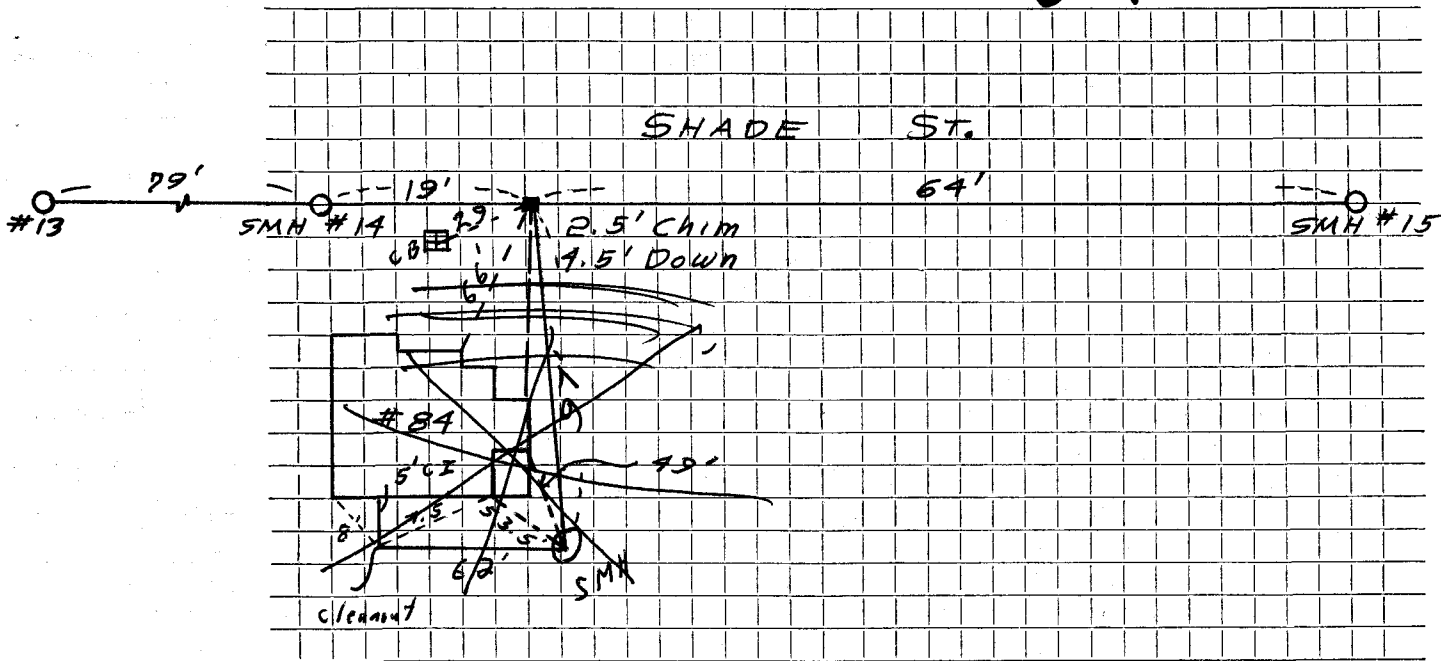


Connection made in ..... Street. Work completed .....

Remarks: 8/98/ DALE THIS SERVICE CEMENTED UP .....

DATE \_\_\_\_\_

TOWN OF LEXINGTON — BOARD OF PUBLIC WORKS  
SEWER DIVISION

Sketch of Service Here  
# 84 SHADE ST

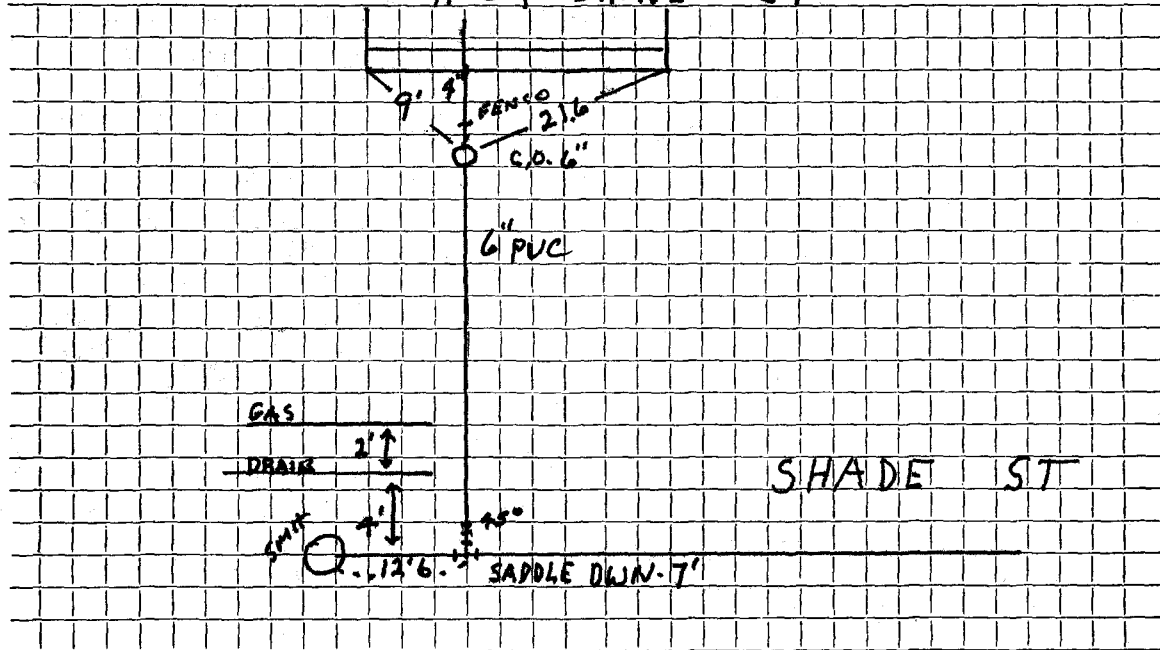

Connection made in SHADE ST Street. Work completed 9/2/98

Remarks: SEWER UNDER DRAIN & GAS