

Name Custom Colonial Inc.

Service No. 169

Address 88 Shade Street

88 Shade Street

Location

Kind of Pipe

Size 6"

Size of Main 8"

~~Repair-Renewal~~ - New Service WO #7682

Location Comm 1-14-62

Date	Material	Amount	Total	Date	Amount
11-14-62	Labor	108.31		10-22-62	Deposit 225.00
11-15-62	"	44.68	152.99	1-14-63	Paid by WHC # 147 34.74
	10% O.H.	15.30	168.29		36.37
	76' 6" Transite pipe @.82		62.32		296.11
	5 hrs. Town Shovel @6.50		32.50		
	3 hrs. Trucking @3.00		9.00		
	1 hr. Loader @5.00		5.00		
	19 x 3 Patch		19.00		
			296.11		


DATE _____

TOWN OF LEXINGTON — BOARD OF PUBLIC WORKS

SEWER DIVISION

Sketch of Service Here

8 8

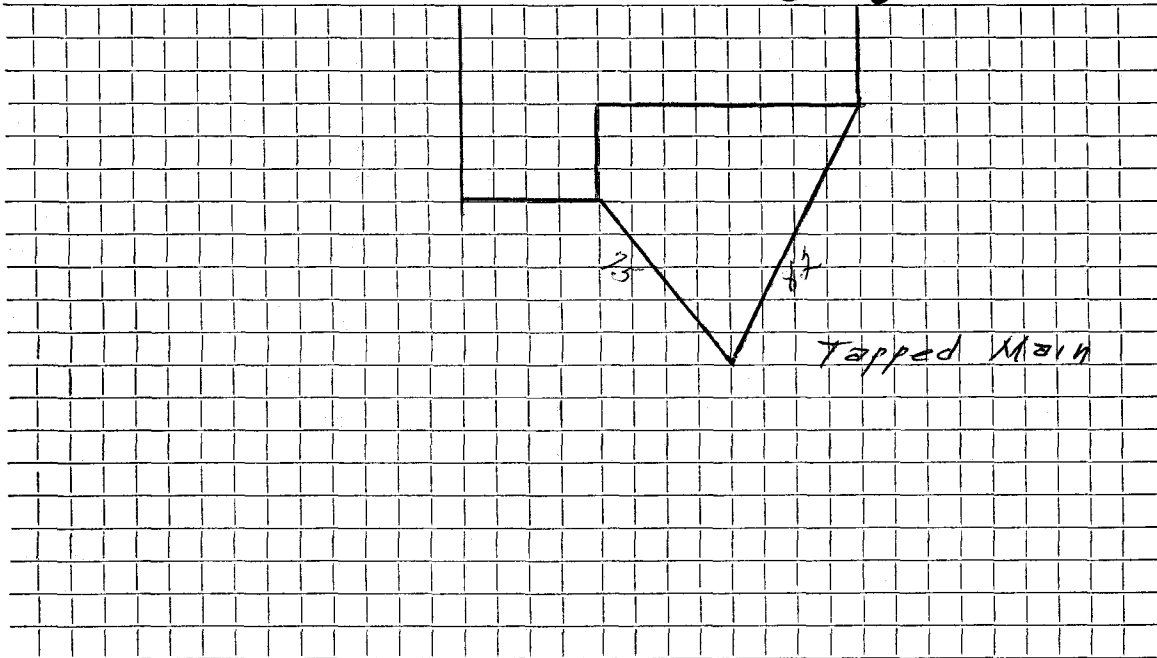

Connection made in Street. Work completed

Remarks:
.....
.....