


DATE 8/4/94

TOWN OF LEXINGTON — BOARD OF PUBLIC WORKS
SEWER DIVISION

Sketch of Service Here 12

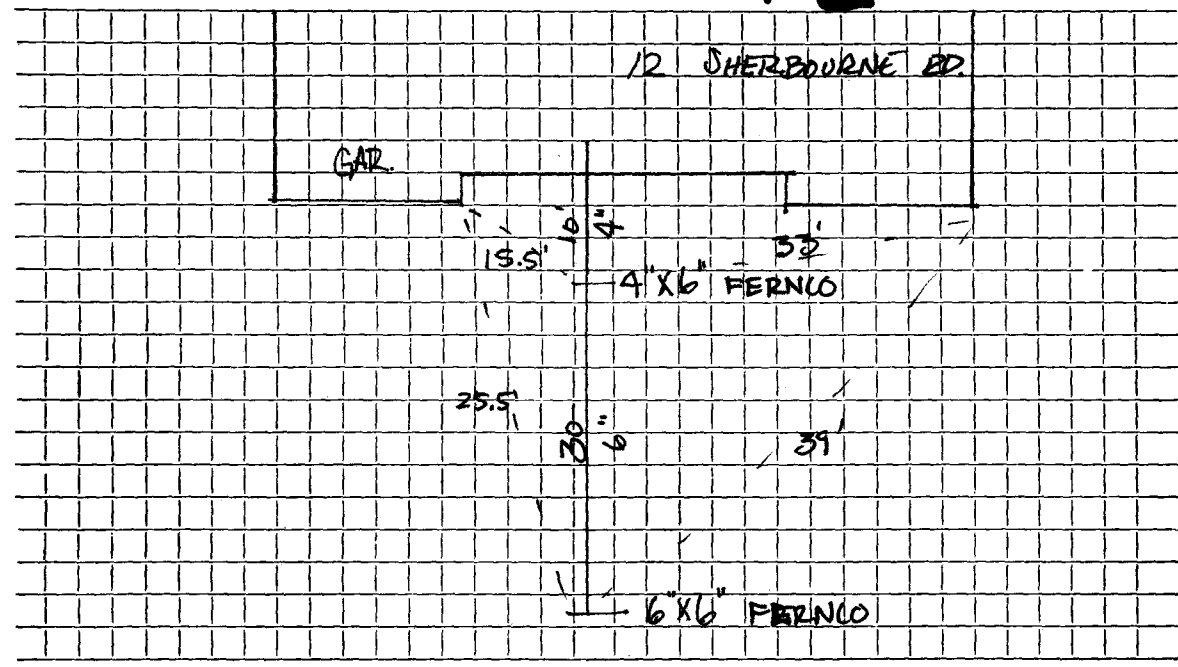

Connection made in Street. Work completed

Remarks: Original Service 3-12-53 (42'-6" Sewer Pipe, 1-6" Elbow)