

Name Robert Shields

Service No. 121

Address 25 Sherburne Road

25 Sherburne Road

Location

Kind of Pipe

Size 6"

Size of Main 8"

Repair—Renewal—New Service

Location Comm 11-24-58

Date	Material	Amount	Total	Date	Amount
7/14/58	Labor	39 19		7-8-58	200 00
7/15/58	"	22 12		11-24-58	72 42
		61 31			127 58
	10% overhead	6 13	67 44		
	48' - 6" Transite pipe @ .70		33 60		
	1 - 6" Transite Elbow 90°		5 29		
	2 hrs. Town Shovel @ 6.50		13 00		
	3 hrs. Trucking @ .75		2 25		
	1 hr. Rodgers trailer		3 00		
	1 hr. Trucking		3 00		
			127 58		
	Labor				

TOWN OF LEXINGTON—DEPT. OF PUBLIC WORKS
SEWER DIVISION

DATE.....

NO.


The undersigned applies for the construction of a particular sewer connecting No.....
Street and hereby agrees to comply with the Rules and Regulations governing the construction and use of Particular
Sewers, as now or at any future time established by the Board of Selectmen.

Am't of estimate \$.....

Am't Paid \$.....

..... Owner

Sketch of Service Here

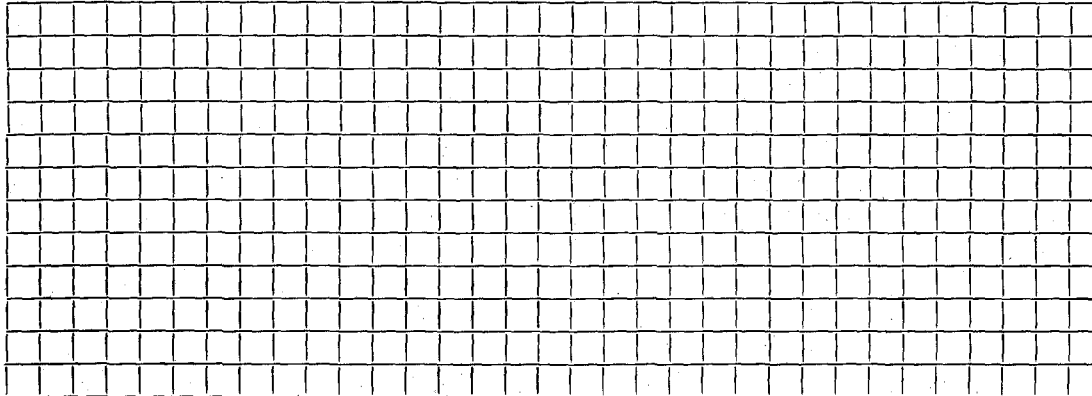

Connection made in..... Street.

Work completed.....19..

Remarks: