

Name Richard Magnanti

Service No. 214

Address 26 Sherburne Road

Lot next to House #22

Location

Kind of Pipe

Size 6"

Size of Main 8"


~~Repair~~ ~~Renewal~~ New ServiceLocation *Comm 2-8-60*

Date	Material	Amount	Total	Date	Amount
5-7-59	Labor	55.04		10-22-59	Deposit 275.00
	10% O.H.	5.50	60.54	2-5-60	* Retard 85.89
	20' 6" Transite pipe @.70		14.00		189.11
	3 hrs. Town Shovel @ 6.50		19.50		
	1 hr. Trucking @.75		.75		
	1 hr. Trucking @3.00		3.00		
	1 hr. Rodgers Trailer @3.00		3.00		
	21 x 3 Patch		21.00		
	BILL WHEN CONNECTED		121.79		
	SERVICE TO SIDE OF ROAD				
10-29-59	Labor	23 84			
	10% O. H.	2 38	26 22		
	30' 6" Transite pipe @.70		21 00		
	1 11 1/2° Transite Bend		5 10		
	3 Hrs. Pippin Shovel @4.50		13 50		
	2 Hrs. Trucking @.75		1 50		
			189 11	* Applied to bill #214	21.85

DATE \_\_\_\_\_

**TOWN OF LEXINGTON — BOARD OF PUBLIC WORKS**  
**SEWER DIVISION**

Sketch of Service Here

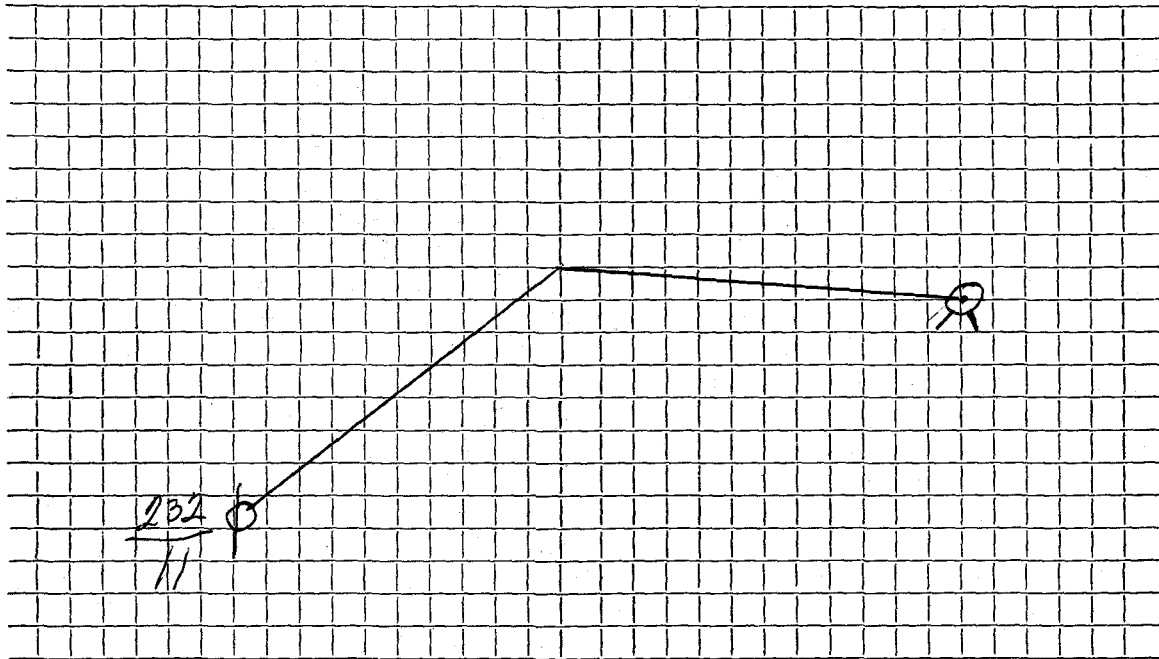

Connection made in ..... Street. Work completed .....

Remarks: .....  
.....  
.....