

Name Henry B. Foster

Service No. 30

Address 27 Sherburne Road

27 Sherburne Road

Location

Kind of Pipe

Size 6"

Size of Main 8"

~~Repair - Renewal~~ — New Service

Location

Date	Material	Amount	Total	Date	Amount
4/25/56	Labor	45 07		4-16-56	<i>Deposited</i>
	10 % Overhead	4 51	49 58	8-6-56	<i>Balance</i>
	46' - 6" sewer pipe @ .3645		16 77		
	1 - 6" Elbow		1 88		
	Joint compound		2 76		
	8 2/3 hrs. Littlefield Shovel @		8.50-73 66		
			144 65		
	Labor				

**TOWN OF LEXINGTON—DEPT. OF PUBLIC WORKS
SEWER DIVISION**

DATE.....

NO.


The undersigned applies for the construction of a particular sewer connecting No.....
Street and hereby agrees to comply with the Rules and Regulations governing the construction and use of Particular
Sewers, as now or at any future time established by the Board of Selectmen.

Am't of estimate \$.....

Am't Paid \$.....

..... Owner

Sketch of Service Here

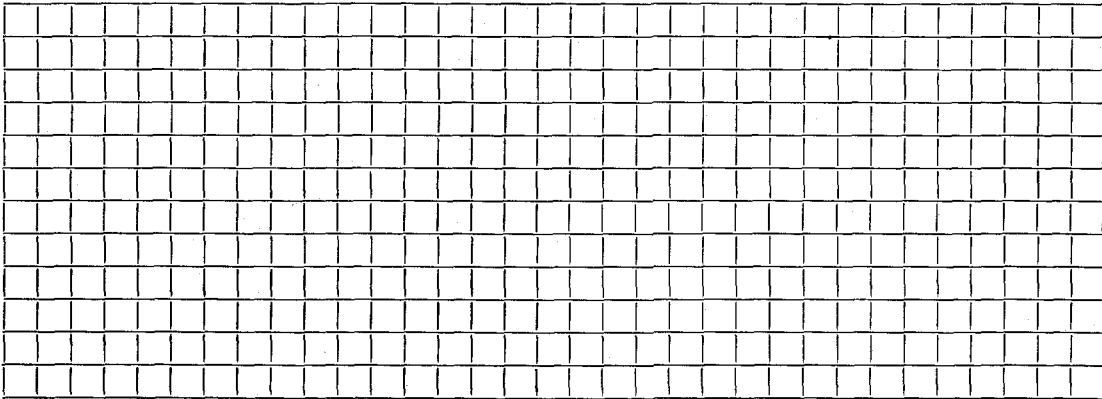

Connection made in..... Street.

Work completed.....19..

Remarks: