

Name Paul Grant

Service No. 2

Address 28 Sherburne Road

28 Sherburne Road

Location

Kind of Pipe

Size 6"

Size of Main 8"

APR 6 1970

~~Repair/Replacement~~ New Service

Eagle #1530

Location


Date	Material	Amount	Total	Date	Amount
1/28/59	Labor	60.18		2/27/70	Deposit
	10% O.H.	6.02	66.20		134.30
	28' 6" Transite pipe	@.70	19.60		
	4 hrs. Town Shovel	@ 6.50	26.00		
	2 hrs. Trucking	@.75	1.50		
	21 x 3 Patch		<u>21.00</u>		
	<u>BILL WHEN CONNECTED</u>		134.30		
1/24/70	34' 6" Transite pipe				
	10' 4" Cast Iron pipe				

DATE \_\_\_\_\_

TOWN OF LEXINGTON — BOARD OF PUBLIC WORKS

SEWER DIVISION

Sketch of Service Here **28**

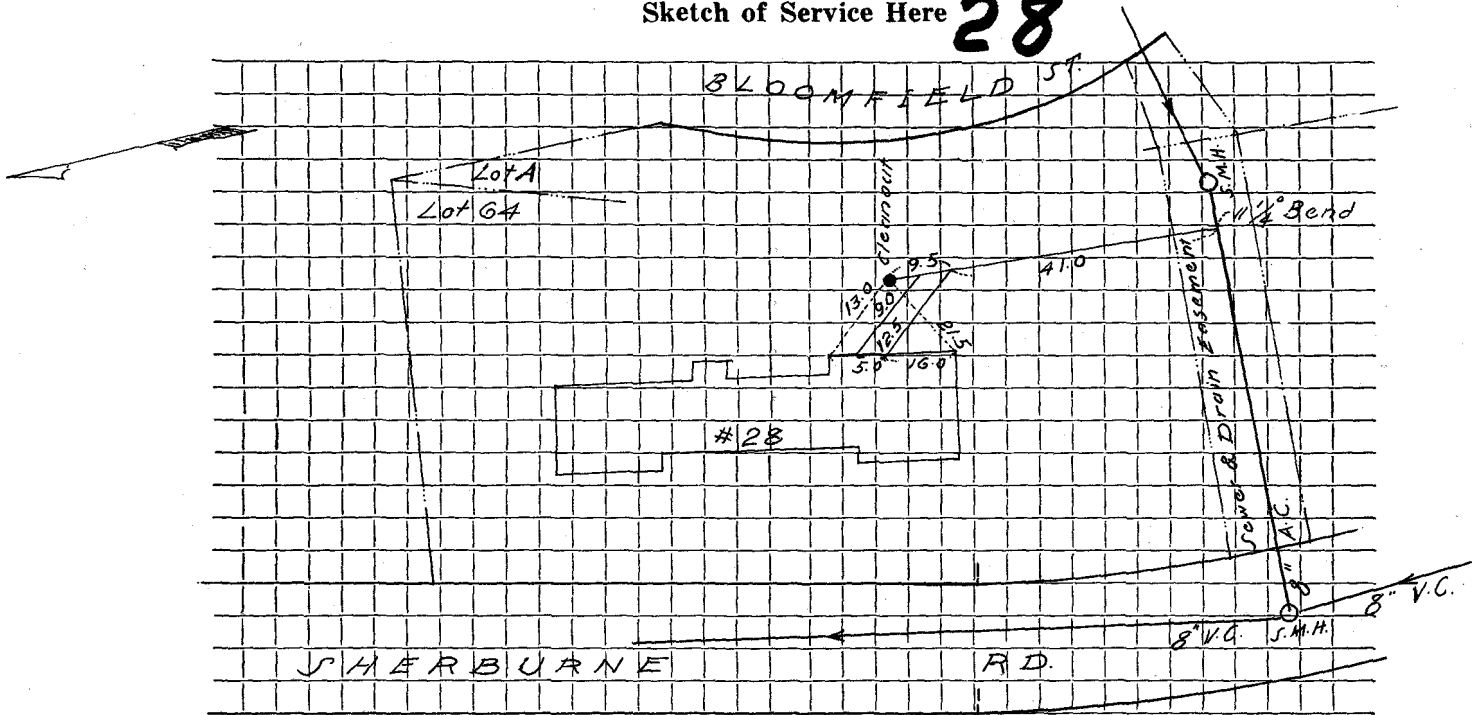

Connection made in ..... Street. Work completed .....

Remarks: .....  
.....  
.....