




DATE 3-22-2016

TOWN OF LEXINGTON — BOARD OF PUBLIC WORKS  
SEWER DIVISION

Sketch of Service Here

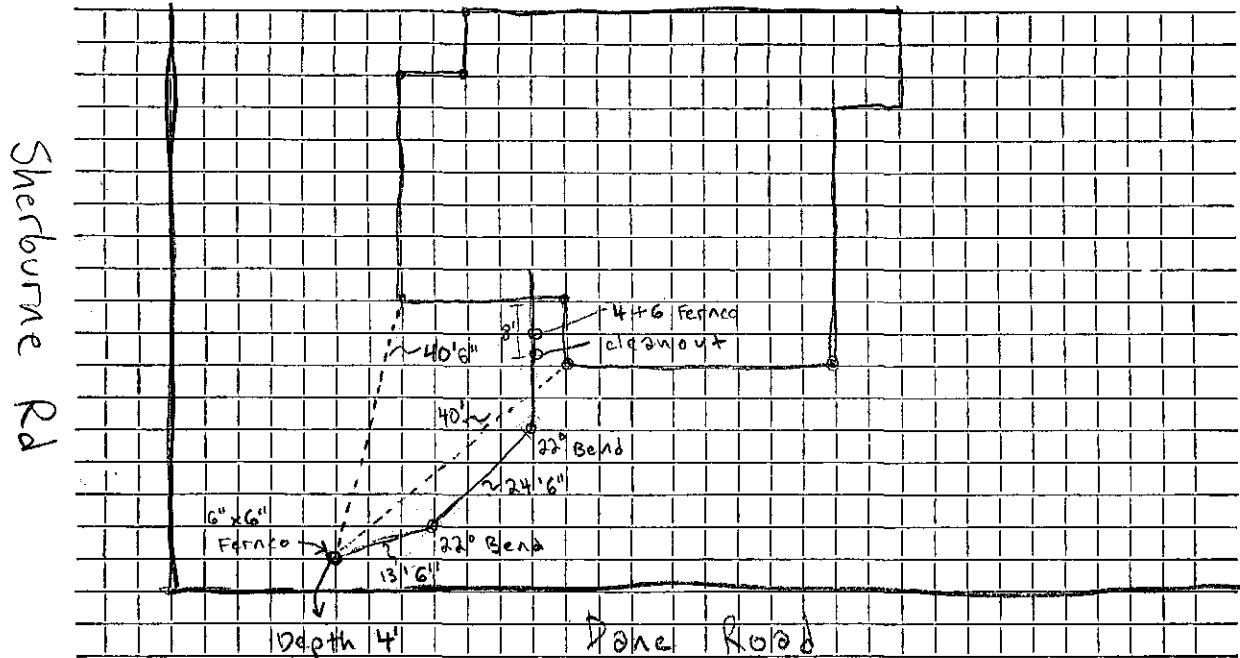

Connection made in 33 Sherburne Road Street. Work completed .....

Remarks: .....

.....

.....