

Name Louis Ciampa

Service No. 72

Address 39 Sherburne Road

39 Sherburne Road

Location

Kind of Pipe

Size 6"

Size of Main 8"

~~Repair/Replacement~~ New Service

Location Comm 7-5-68

Date	Material	Amount	Total	Date	Amount
6-11-59	Labor	25.10		5-10-60	Deposit 100.00
	10% O.H.	2.51	27.61	7-5-60	Paid by W.H.C.#67 20.69
	24' 6" Sewer pipe @.70		16.80	7-19-60	Paid 50.74
	1 hr. Trucking @.75		.75		171.43
	(BILL WHEN CONNECTED)		45.16		
5-17-60	Labor	57.24			
	10% O.H.	5.72	62.96		
	40' 6" Transite pipe @.78		31.20		
	1 22 $\frac{1}{2}$ ° Transite Bend		6.21		
	1 6" Duplex Adapter		1.90		
	2 hrs. Town Shovel @6.50		13.00		
	2 hrs. Trucking @3.00		6.00		
	1 hr. <del>Labor</del> Rogers Trailer @3.00		3.00		
	2 hrs. Pumping @1.00		2.00		
			171.43		
				Bill sent 7-5-68	50.74

TOWN OF LEXINGTON—DEPT. OF PUBLIC WORKS  
**SEWER DIVISION**

DATE.....

NO. ....


The undersigned applies for the construction of a particular sewer connecting No.....  
Street and hereby agrees to comply with the Rules and Regulations governing the construction and use of Particular  
Sewers, as now or at any future time established by the Board of Selectmen.

Am't of estimate \$.....

Am't Paid \$.....

..... Owner

Sketch of Service Here **39**

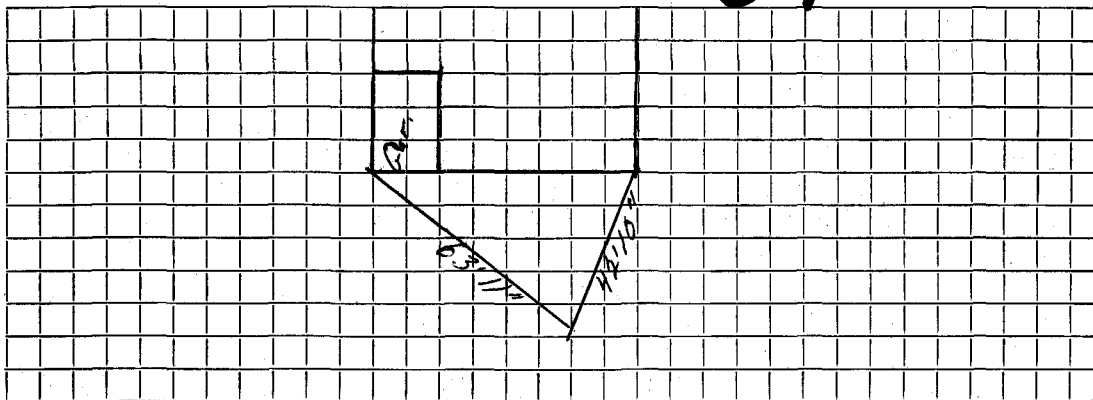

Connection made in..... Street.

Work completed.....19..

Remarks: