

Name David J. BRIGGS

Service No. 76

Address 5 Sherburne Rd.

5 Sherburne Road

Location

Kind of Pipe

Size 6"

Size of Main 8"

~~Repair~~ ~~Renewal~~ ~~New~~ ServiceBrucchi #3098
NO. 32


Location NOV. 13 1978

Date	Material	Amount	Total	Date	Amount
				11-20-78	Deposit 200.00
10-30-78	Labor	125.50		12-5-78	Paid 7.29
	10% O.H.	12.55	138.05		207.29
	10' 6" Transite Pipe @ 1.50		15.00		
	1 6" x 8" Saddle		22.29		
	1 12" Nipple		2.76		
	1 24" Nipple		6.11		
	1 90° Transite elbow		6.21		
	1 6" Cap		4.12		
	1 hr. Trucking		3.00		
	1/2 hrs Backhoe @ 6.50	6.50	9.75		
			207.29		
11/2/78	38' of 6" ACP				
	6' of 4" CI				

DATE _____

TOWN OF LEXINGTON — BOARD OF PUBLIC WORKS
SEWER DIVISION

Sketch of Service Here **5**

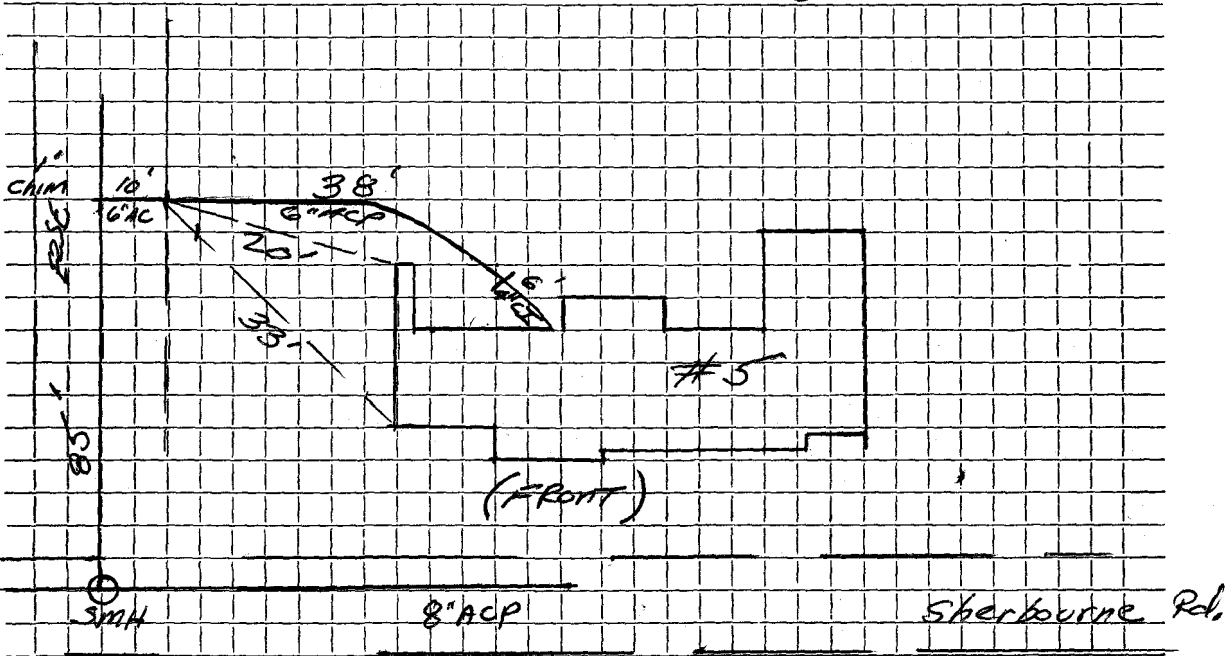

Connection made in E 25th Street. Work completed

Remarks:
.....
.....