

Name Christos Fatouros

Service No. 73

Address 52 SHERBURNE RD.

lot 24 52 Sherburne Rd. Location

Kind of Pipe A.C.

Size 6"

Size of Main 8"

~~Repair~~ ~~Renewal~~ ~~New Service~~

J. DEVINE
3034

Location


FEB 13 1978

Date	Material	Amount	Total	Date	Amount
9/14/77	35'-6" AC 10'-4" CI			9-6-77	Deposit 37.47
3-22-60	Labor	13.08			
	10% O.H.	1.31	14.39		
	20' 6" Transite pipe @.78		15.60		
	2 6" 11 1/4° Elbow @2.24		4.48		
	1 hr. Trucking @3.00		3.00		
			37.47		

DATE _____

TOWN OF LEXINGTON — BOARD OF PUBLIC WORKS
SEWER DIVISION

Sketch of Service Here **52**

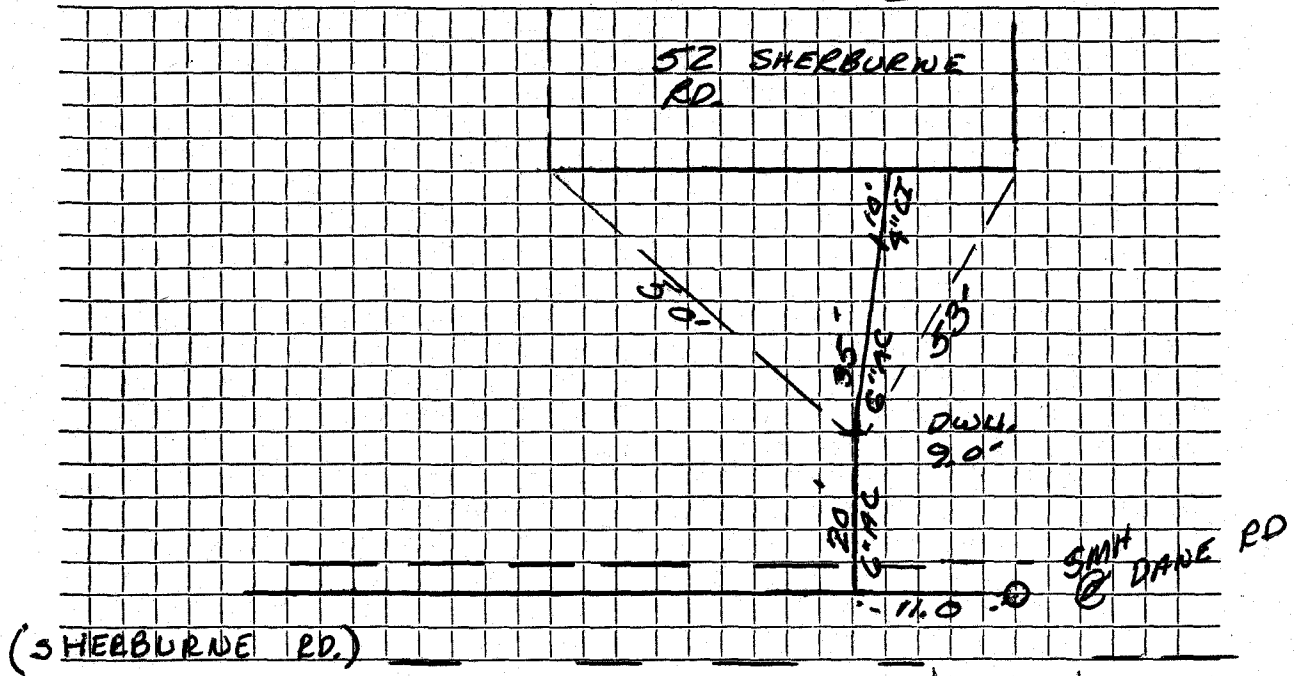

Connection made in ... SHERBURNE RD. ... Street: Work completed |.....|.....

Remarks:

.....

.....