

Name George Bromberg

Service No. 18

Address 54 Sherburne Rd.

54 Sherburne Road

Location

Kind of Pipe

Size 6"

Size of Main 8"

New Service Valeri #3278

Location AUG 8 1977


Date	Material	Amount	Total	Date	Amount
5/20/77	labor	164. 22		4/28/77	Deposit 260. 00
	10%OH	16. 42	180. 64	8/8/77	Paid by WHCH#7 110. 85
10'	6" Transite @ 1.51		15. 10	9-12-77	Paid 86. 76
1	6" X 5' nipple @ 1.76		8. 80		457. 69
1	6" X 2' nipple		5. 60		
1	6" X 1' nipple		2. 50		
1	6" X 90° elbow		5. 65		
6	tons 3/4 stone @ 4.50		27. 00		
6	tons gravel @ 3.00		18. 00		
3	ton cold patch @ 13.30		39. 90		
3	hrs. trucking @ 3.00		9. 00		
3	hrs. town shovel @ 6.50		19. 50		
	hot top 21' X 9'		126. 00		
			457. 69		
5/24/77	32' 6" Transite Pipe				
	10' 4" Cast Iron				

DATE _____

TOWN OF LEXINGTON — BOARD OF PUBLIC WORKS

SEWER DIVISION

Sketch of Service Here **54**

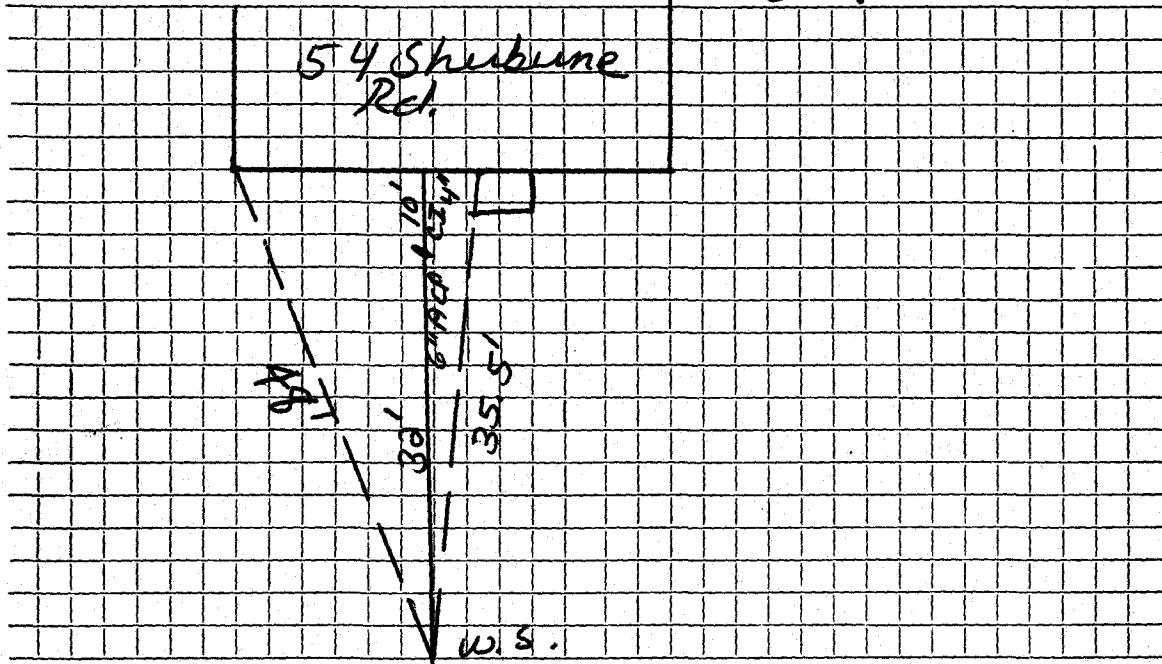

Connection made in Street. Work completed

Remarks:
.....
.....