


DATE _____

TOWN OF LEXINGTON — BOARD OF PUBLIC WORKS
SEWER DIVISION

Sketch of Service Here **56**

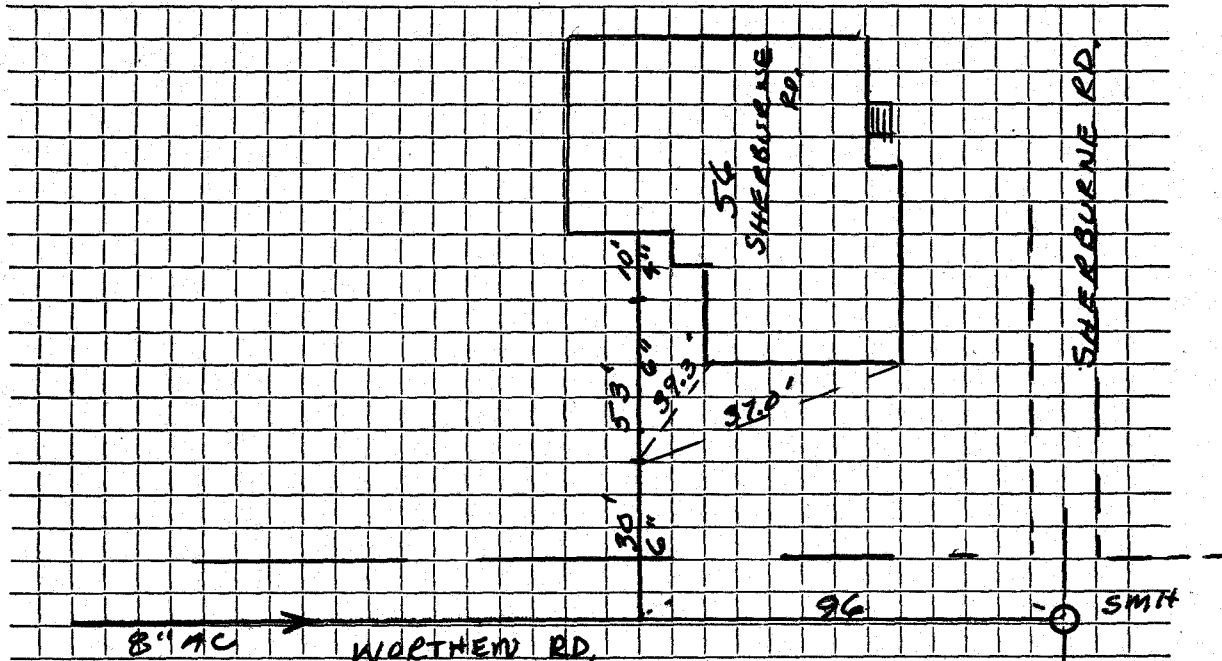

Connection made in WORTHEN RD. Street. Work completed

Remarks: