

Name Louis Stoico Inc.

Service No. 79

Address 58 Sherburne Road

58 Sherburne Road

Location

Lot 27

Kind of Pipe

Size 6"

Size of Main 8"

~~Work Removal~~—New Service Eagle #1704


Location DEC 31 1970

Date	Material	Amount	Total	Date	Amount
8-22-60	Labor	13 08		8-18-70	32 99
	10% O.H.	<u>1 31</u>	14 39	<i>Deposit</i>	
	20' 6" transite pipe@78		15 60		
	1 Hr. trucking@3.00		<u>3 00</u>		
	BILL WHEN CONNECTED		32 99		
8/19/70	38' 6" Transite pipe				
	10' 4" Cast Iron pipe				

DATE \_\_\_\_\_

TOWN OF LEXINGTON — BOARD OF PUBLIC WORKS

SEWER DIVISION

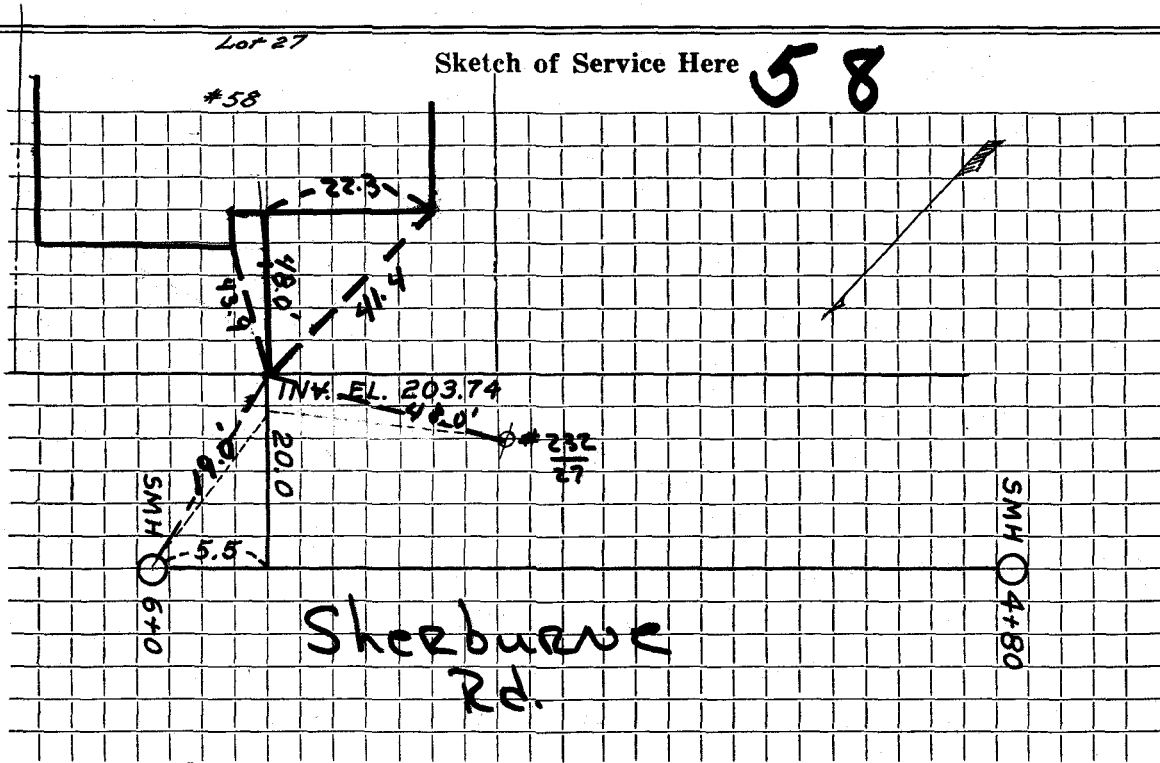

Connection made in ..... Street. Work completed .....

Remarks: .....

.....

.....