




DATE Nov 28, 1984

TOWN OF LEXINGTON — BOARD OF PUBLIC WORKS  
SEWER DIVISION

Sketch of Service Here **6**

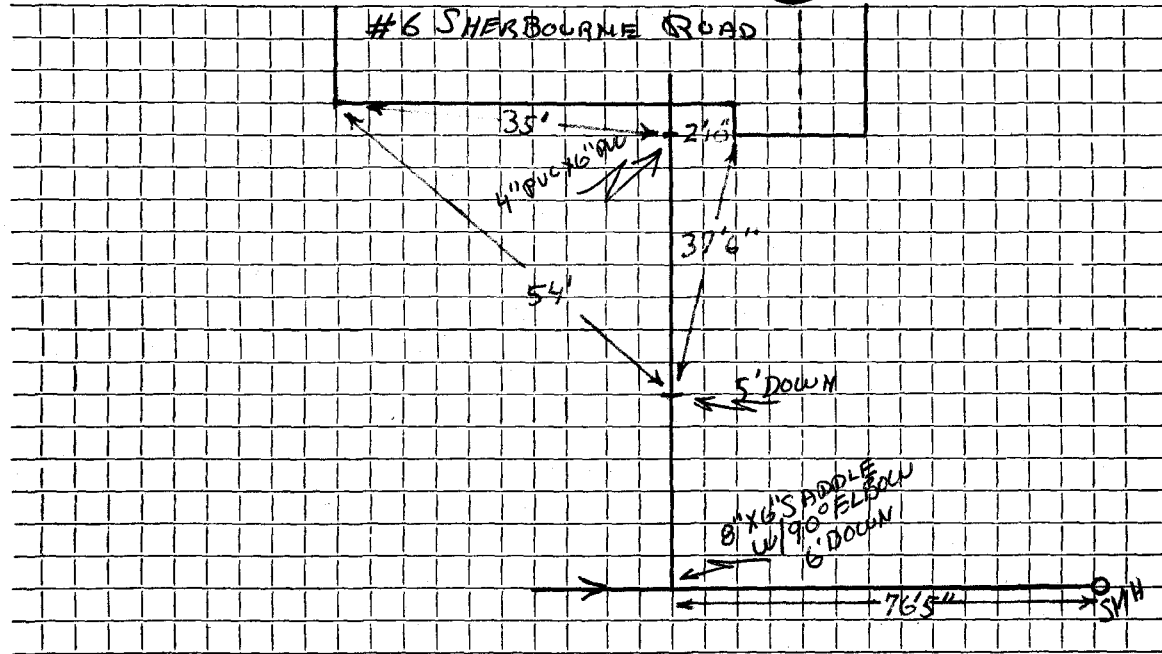

Connection made in SHERBOURNE ROAD Street.

Work completed Nov 27, 1984

Remarks: .....

.....