

Name Louis Ciampa

Service No. 71

Address 60 Sherburne Road

60 Sherburne Road

Location Lot 28

Kind of Pipe

Size 6"

Size of Main 8"

~~Repair~~ ~~Renewal~~ — New Service DeFlice #680


Location *Comp 10-30-67*

Date	Material	Amount	Total	Date	Amount
8-19-60	Labor	13 08		<i>6-22-67</i>	<i>Deposit</i>
	10% O.H.	1 31	14 39		<i>27 43</i>
	10' 6" transite pipe@78		7 80		
	1 11 1/2° transite bend		2 24		
	1 Hr. trucking@3.00		3 00		
	BILL WHEN CONNECTED		27 43		
6-22-67	48' 6" Transite pipe				
	10' 4" Cast Iron pipe				
				<i>4-9-74</i>	<i>solids 54' out</i>

DATE \_\_\_\_\_

TOWN OF LEXINGTON — BOARD OF PUBLIC WORKS  
SEWER DIVISION

Sketch of Service Here **60**

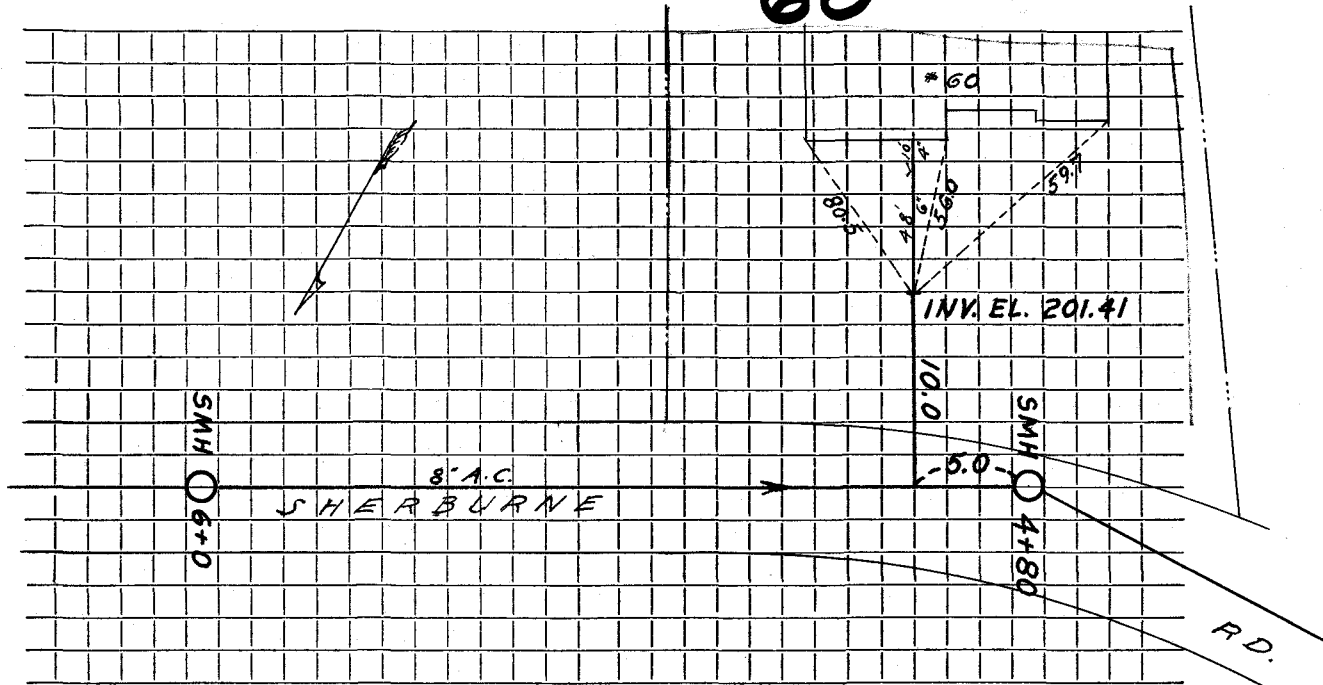

Connection made in ..... Street. Work completed .....

Remarks: .....  
.....  
.....