

Name Louis Ciampa

Service No. 100

Address 61 Sherburne Road

61 Sherburne Road

Location

Lot 36

Kind of Pipe

Size 6"

Size of Main 8"

~~Repair~~ ~~Renew~~ ~~Work~~ - New Service

DeFlice Bros #1209

Location

JAN 27 1969


Date	Material	Amount	Total	Date	Amount
3-22-60	Labor	13 08		10-15-68	35 99
	10% O.H.	<u>1 31</u>	14 39	<i>Deposit</i>	
	20' 6" transite pipe@78		15 60		
	1 Hr. trucking@3.00		<u>3 00</u>		
	BILL WHEN CONNECTED		32 99		
10-21-68	39' 6" Transite pipe				
	10' 4" Cast Iron pipe				

DATE \_\_\_\_\_

TOWN OF LEXINGTON — BOARD OF PUBLIC WORKS

SEWER DIVISION

Sketch of Service Here **61**

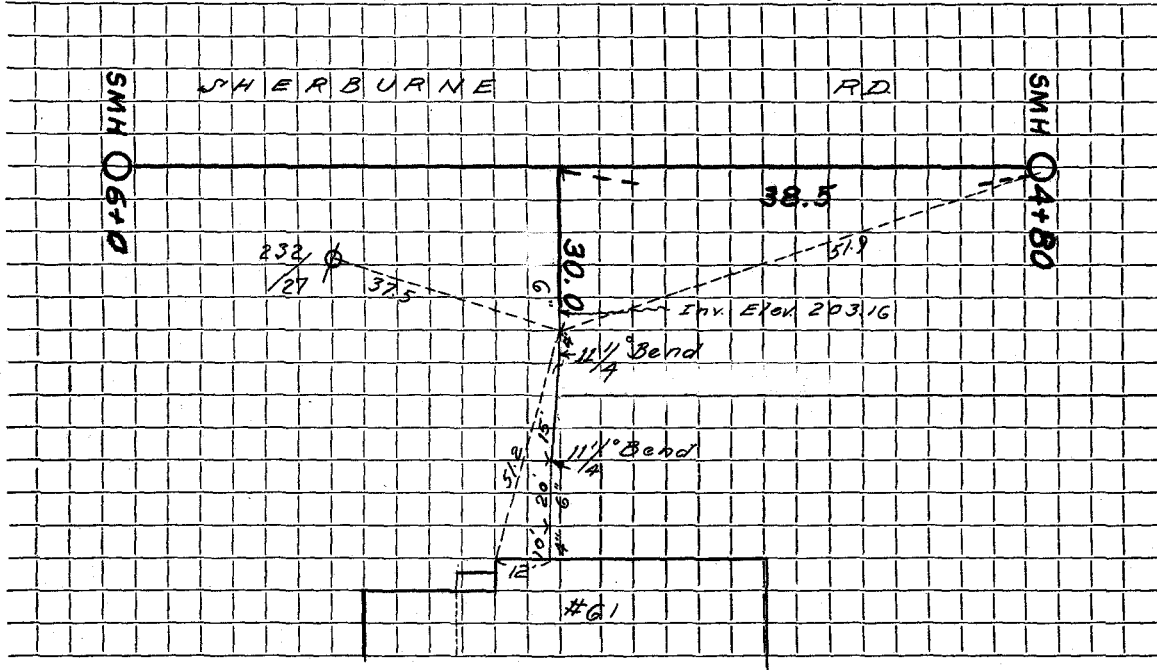

Connection made in ..... Street. Work completed .....

Remarks: .....  
.....  
.....