

Name Louis StoicoService No. 121Address 63 Sherburne Road63 Sherburne RoadLocation Lot 35

Kind of Pipe

Size 6"Size of Main 8"REPAIRS/REWORK — New ServiceDavid Eagle Permit #58Location Comp 2-21-64


Date	Material	Amount	Total	Date	Amount
8-19-60	Labor	13 08		<u>2-22-64</u>	<u>Deposit</u>
	10 @ O.H.	<u>1 31</u>	14 39		<u>32 99</u>
	20' 6" transite pipe@78		15 60		
	1 Hr. trucking@3.00		<u>3 00</u>		
	BILL WHEN CONNECTED		<u>32 99</u>		
7-24-64	31' 6" Transite pipe				

DATE _____

TOWN OF LEXINGTON — BOARD OF PUBLIC WORKS

SEWER DIVISION

Sketch of Service Here **63**

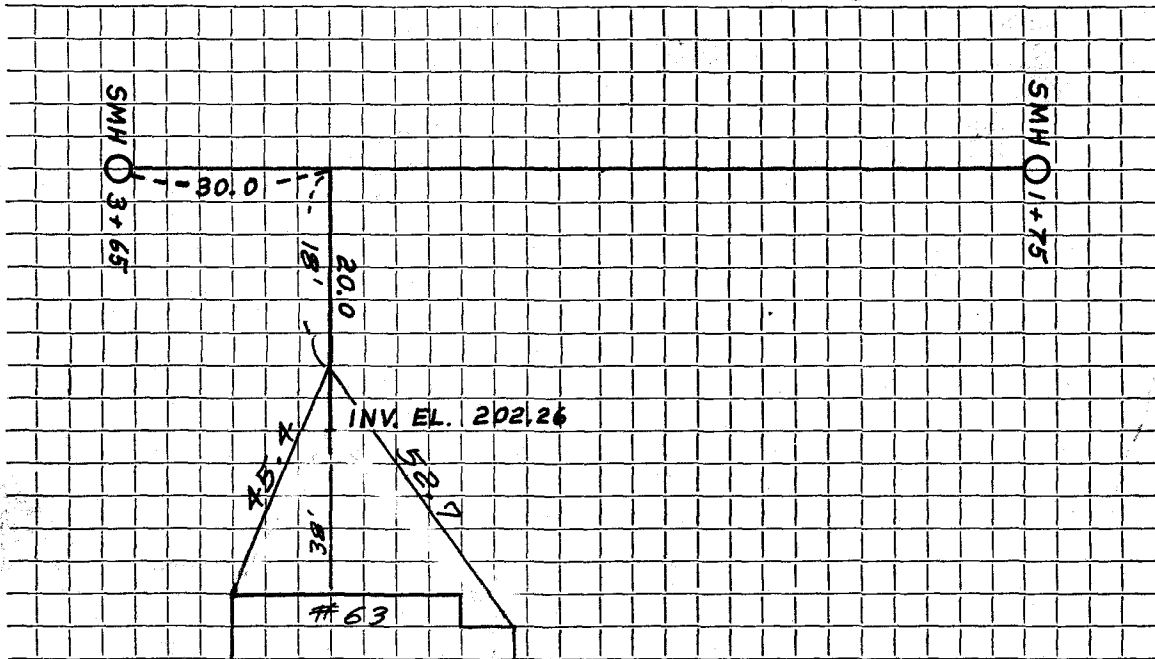

Connection made in Street. Work completed

Remarks:
.....
.....