

Name Louis Stocio

Service No. 122

Address 65 Sherburne Road

Lot 34 65 Sherburne Rd. Location Lot 34

Kind of Pipe

Size 6"

Size of Main 8"

~~Repair~~ ~~Renewal~~ ~~XXXXXX~~ New Service

David Eagle - Permit #59


Location Conn 9-21-64

Date	Material	Amount	Total	Date	Amount
-19-60	Labor	13 08		7-22-64	32 99
	10% O.H.	1 31	14 39		
	20' 6" transite pipe@78		15 60		
	1 Hr. trucking@3.00		3 00		
	BILL WHEN CONNECTED		32 99		
7-24-64	38' 6" Transite pipe				

DATE \_\_\_\_\_

TOWN OF LEXINGTON — BOARD OF PUBLIC WORKS  
SEWER DIVISION

Sketch of Service Here **65**

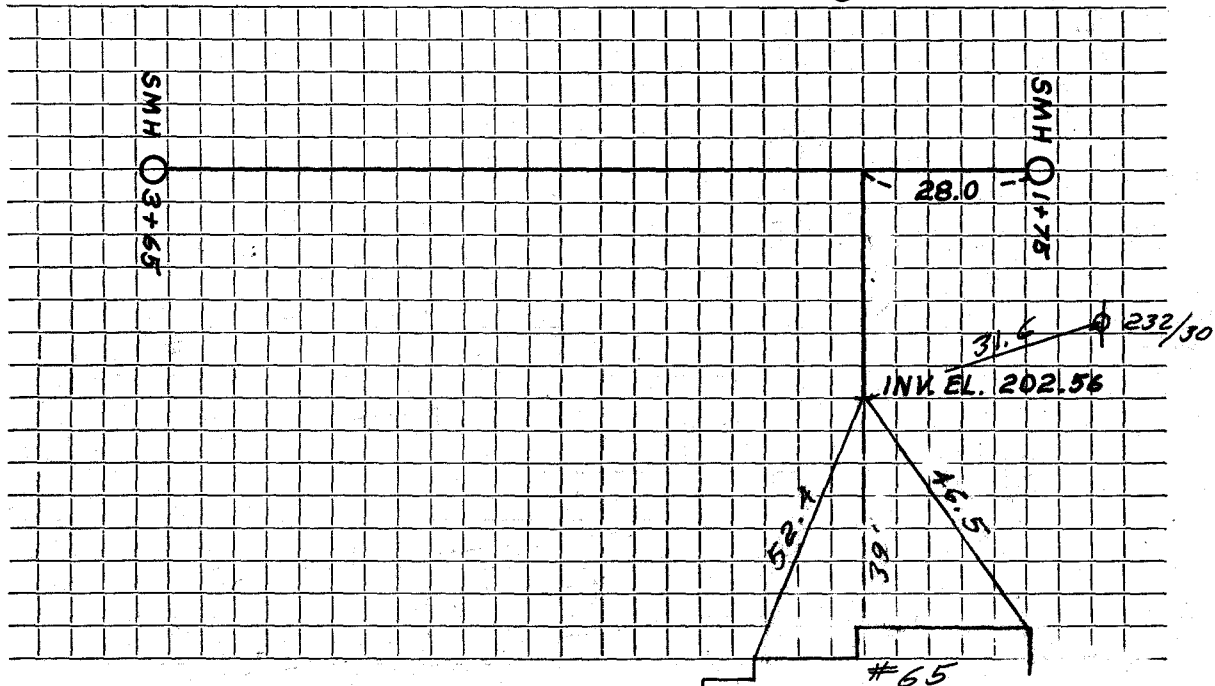

Connection made in ..... Street. Work completed .....

Remarks: .....  
.....  
.....