

DATE _____


TOWN OF LEXINGTON — BOARD OF PUBLIC WORKS

SEWER DIVISION

66 STERBUNNE

66

Sketch of Service Here ROAD

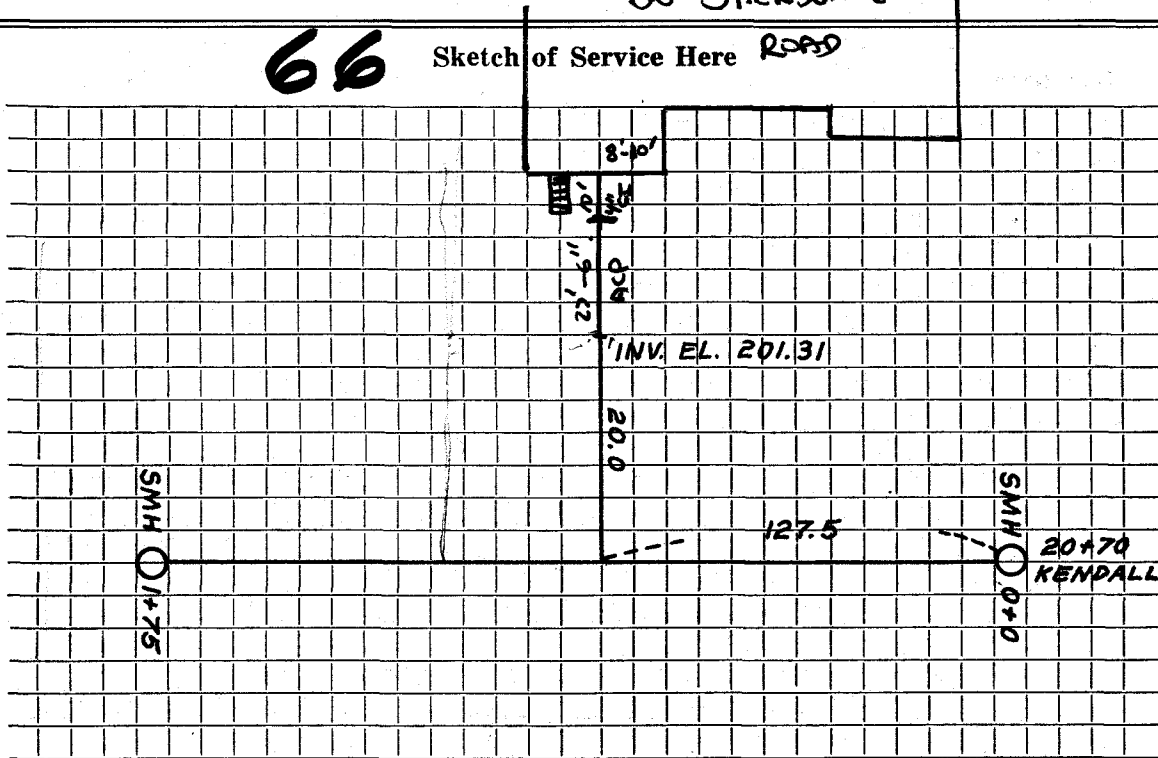

Connection made in Street. Work completed

Remarks:
.....
.....