


DATE _____

TOWN OF LEXINGTON — BOARD OF PUBLIC WORKS
SEWER DIVISION

Sketch of Service Here **67**

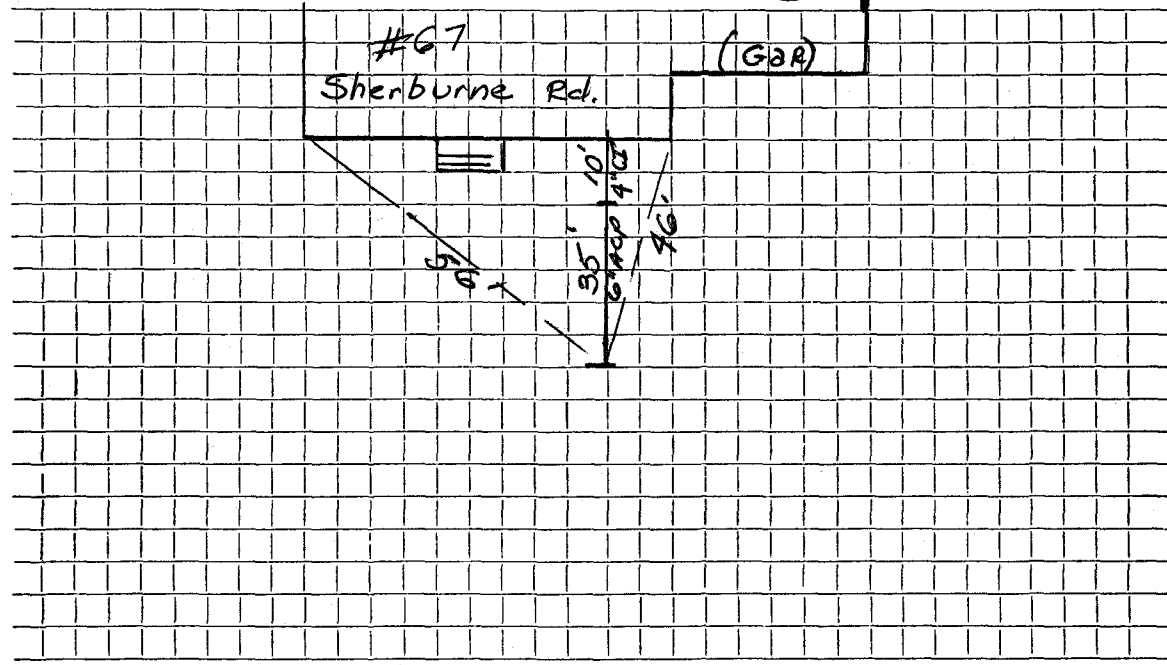

Connection made in Street. Work completed

Remarks: *Original Service 8-19-60*