

Name Francis C. Nelson

Service No. 19

Address 8 Sherburne Rd.

Lexington 8 Sherburne Road Location

Kind of Pipe

Size 6"

Size of Main 8"

~~Repair~~ ~~Renewal~~ New Service

Com. 3/30/53

Location

Date	Material	Amount	Total	Date	Amount
3/11/53	Labor	45 59		3-9-53	Deposited 50 00
	10 % Overhead	4 56	50 15	3-30-53	Refunded (50 25)
	50' - 6" sewer pipe @.342		17 10		99 75
	Joint compound		3 00		
	4 hrs. Littlefield shovel		28 00		
	2 hrs. trucking		1 50		
			99 75		
	Labor				

**TOWN OF LEXINGTON—DEPT. OF PUBLIC WORKS**  
**SEWER DIVISION**

DATE.....

NO. ....

The undersigned applies for the construction of a particular sewer connecting No.....  
Street and hereby agrees to comply with the Rules and Regulations governing the construction and use of Particular  
Sewers, as now or at any future time established by the Board of Selectmen.


Am't of estimate \$. ....

Am't Paid \$. ....

..... Owner

---

**Sketch of Service Here**

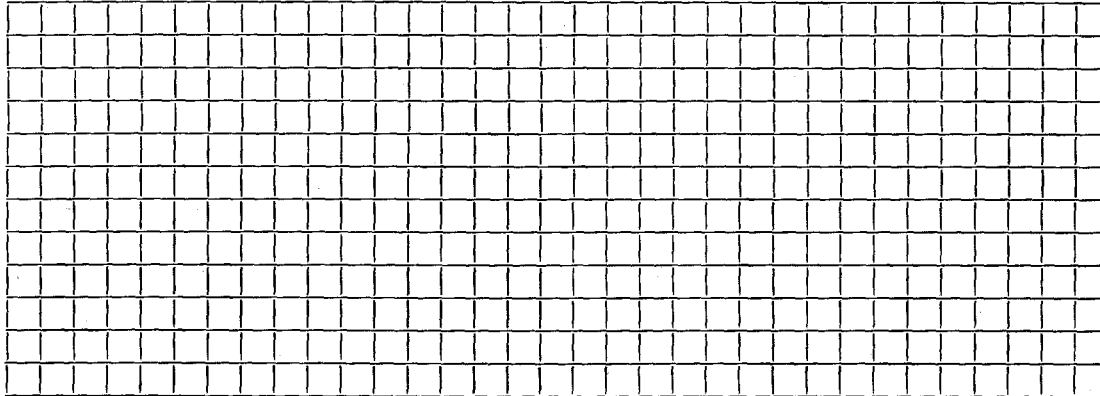

Connection made in..... Street.

Work completed.....19..

Remarks: