

Name **Mary E. Douglass**

Service No. **15**

**878**

Address **11 ~~10~~ Sheridan Street**

**11 Sheridan Street** Location **11 Sheridan Street**

Kind of Pipe

Size **6"**

Size of Main **8"**

Repair—Renewal—New Service

Location

Date 1939	Material	Amount	Total	Date	Amount
Sept. 4, <i>pm 9/11/39</i>	8 hrs. @ 55¢	4 40	1 00	September, 1939	Deposited 20 00
	87' 3/4" @ 60¢ tubing	<u>52 80</u>	9 20		
	10% Overhead I.S. & W		92		
	40' 6" Sewer pipe @ 20¢		8 00		
	Jointing compound		2 40		
	2 hrs. trucking @ 75¢		<u>1 50</u>		
			<u>22 02</u>		
	Charge Flat Rate \$20.00				
	Labor				

Hadley Press, Inc., Lexington

TOWN OF LEXINGTON—BOARD OF PUBLIC WORKS

SEWER DIVISION

DATE August 31, 1959


NO. \_\_\_\_\_

The undersigned applies for the construction of a particular sewer connecting No. 11 Sheridan St. Street and hereby agrees to comply with the Rules and Regulations governing the construction and use of Particular Sewers, as now or at any future time established by the Board of Selectmen.

Am't. of Estimate \$ 20<sup>00</sup>

Am't. Paid \$ \_\_\_\_\_

Mary C Douglas Owner

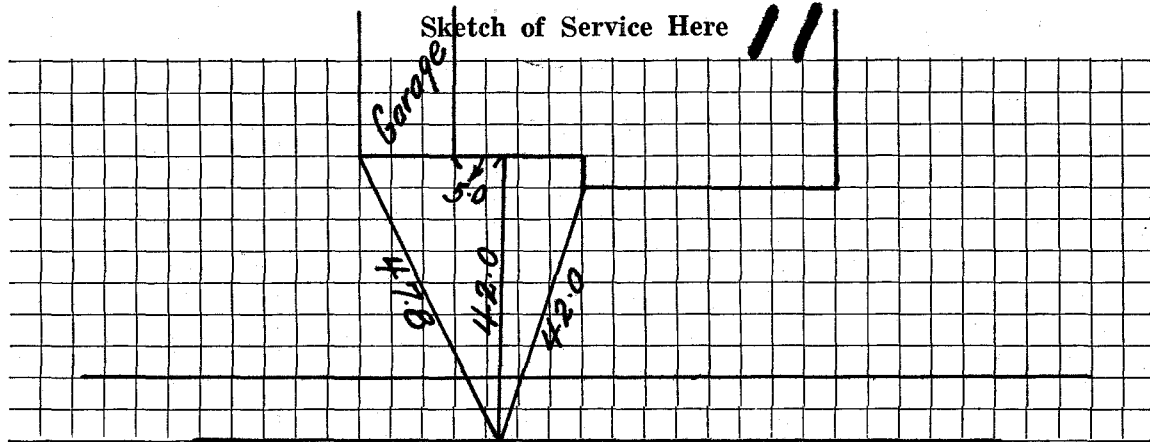

Connection made in \_\_\_\_\_ Street.

Work completed \_\_\_\_\_ 19

Remarks: