

Name

Service No.

824

Address

3 Sheridan St.

3 Sheridan ST.

Location

3 Sheridan Street

Kind of Pipe

Size 6"

Size of Main 8"

Repair—Renewal—New Service

Location

Date

Material

Amount

Total

Date

Amount

Labor

TOWN OF LEXINGTON—BOARD OF PUBLIC WORKS
SEWER DIVISION

DATE _____


NO. _____

The undersigned applies for the construction of a particular sewer connecting No. 3 Sheridan Street Street and hereby agrees to comply with the Rules and Regulations governing the construction and use of Particular Sewers, as now or at any future time established by the Board of Selectmen.

Am't. of Estimate \$ _____

Am't. Paid \$ _____

Owner

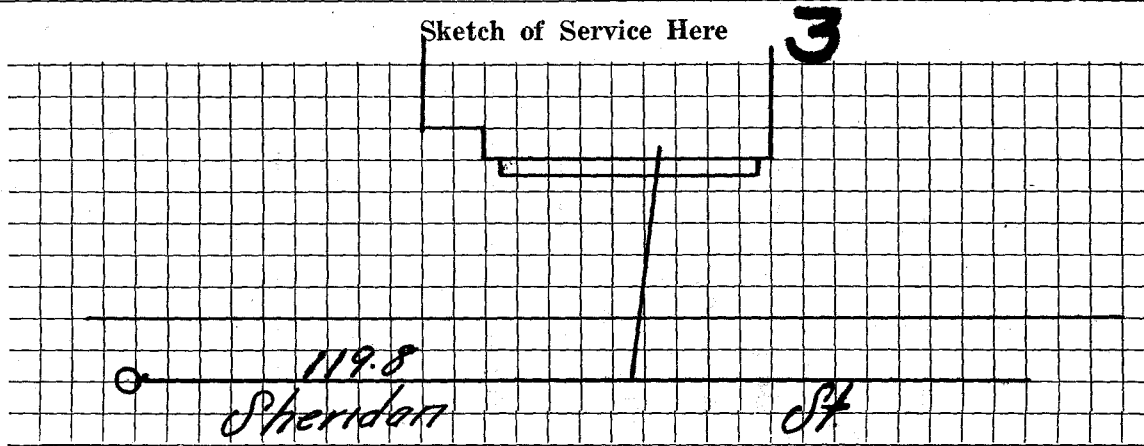

Connection made in _____ Street.

Work completed _____ 19

Remarks: