

Name Mrs. R. J. Balmer

Service No. 10 876

Address 7 Sheridan St.

7 Sheridan St.

Location 7 Sheridan Street

Kind of Pipe

Size 6"

Size of Main 8"

~~Repair-Renewal~~ - New Service

Location

Date	Material	Amount	Total	Date	Amount
P. 4-15-30 for 49.58	33' 6" Sewer Pipe @.30	9 90			
	Sulphur & Jute	1 32		March 17 1930 - Cash	25 -
	Trucking	<u>75</u>	11 97	April 26 1930 - Cash	24 58
/5/30	54 Hrs. Labor @.55	29 70			
	5 " " @.60	<u>3 00</u>	32 70		
	15% Overhead		<u>4 91</u>		
			<u>49 58</u>		
	Labor				

TOWN OF LEXINGTON—BOARD OF PUBLIC WORKS
SEWER DIVISION

DATE _____


The undersigned applies for the construction of a particular sewer connecting No. March 17, 1990 NO. _____ Street and hereby agrees to comply with the Rules and Regulations governing the construction and use of Particular Sewers, as now or at any future time established by the Board of Selectmen.

Am't. of Estimate \$ 80⁰⁰

Am't. Paid \$ 25⁰⁰

1 Mrs R J Balmer Owner
7 Sheridan St

Sketch of Service Here

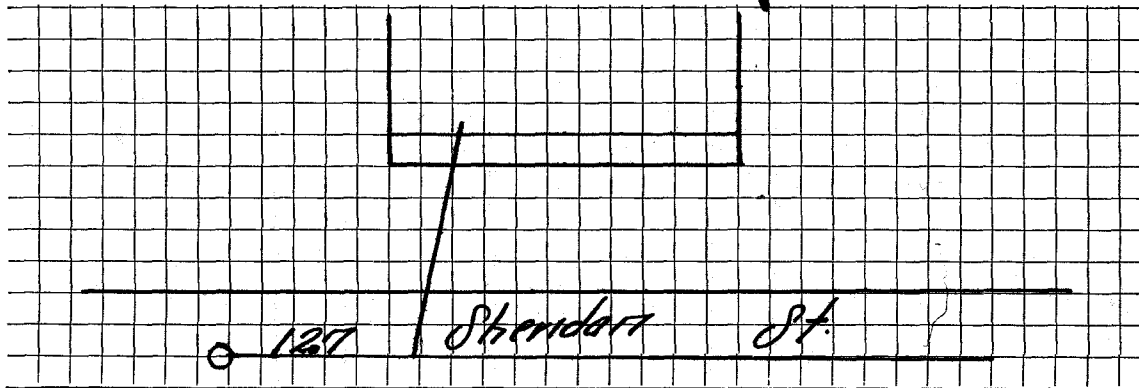

Connection made in _____ Street.

Work completed _____ 19

Remarks: