


DATE June 29, 2020

TOWN OF LEXINGTON — BOARD OF PUBLIC WORKS
SEWER DIVISION

Sketch of Service Here

Cleanout
45° bend

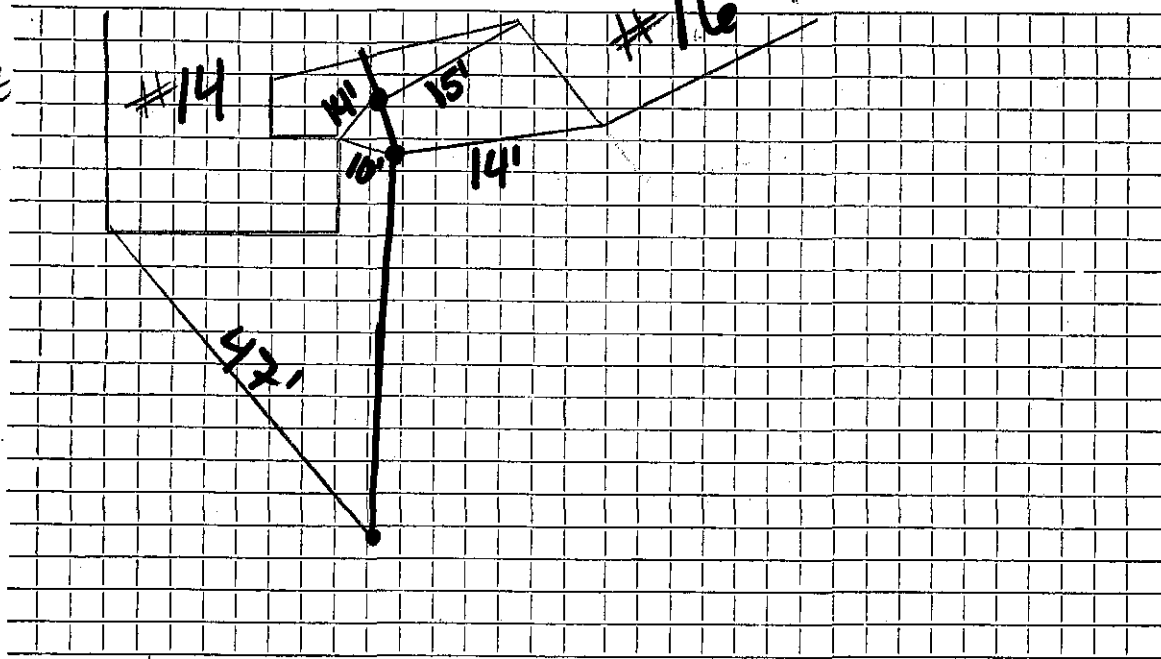

Connection made in Sherman Street. Work completed

Remarks: 14-16 Sherman St
.....
.....