

Name Lucy Kelly

Service No. 9

Address 14 Sherman Street

14 Sherman Street

Location

AUG 6 1979

Kind of Pipe

Size 6"

Size of Main 8"

~~Repair~~ ~~Renewal~~ ~~New Service~~ W.O. #325

Location


Date	Material	Amount	Total	Date	Amount
6-22-79	Labor	42.34		4-6-79	150.00
	10% O.H.	4.23	46.57	8-6-79	32.97
10'	6" Transite @ 1.91		19.10		117.03
1	5' Nipple @ 2.33		11.65		
1	6" Transite to Clay Adapter		7.53		
6	Brick @ .09		54		
1/4	Bag Cement		1.06		
1	Hr. Trucking		3.00		
2	Hrs. Backhoe @ 6.50		13.00		
2	Yds. Loam @ 5.44		10.88		
5	Lbs. Seed @ .74		3.70	9/14/92	Response & measure <i>(initials)</i>
			\$ 117.03		

DATE _____

TOWN OF LEXINGTON — BOARD OF PUBLIC WORKS

SEWER DIVISION

Sketch of Service Here **14**

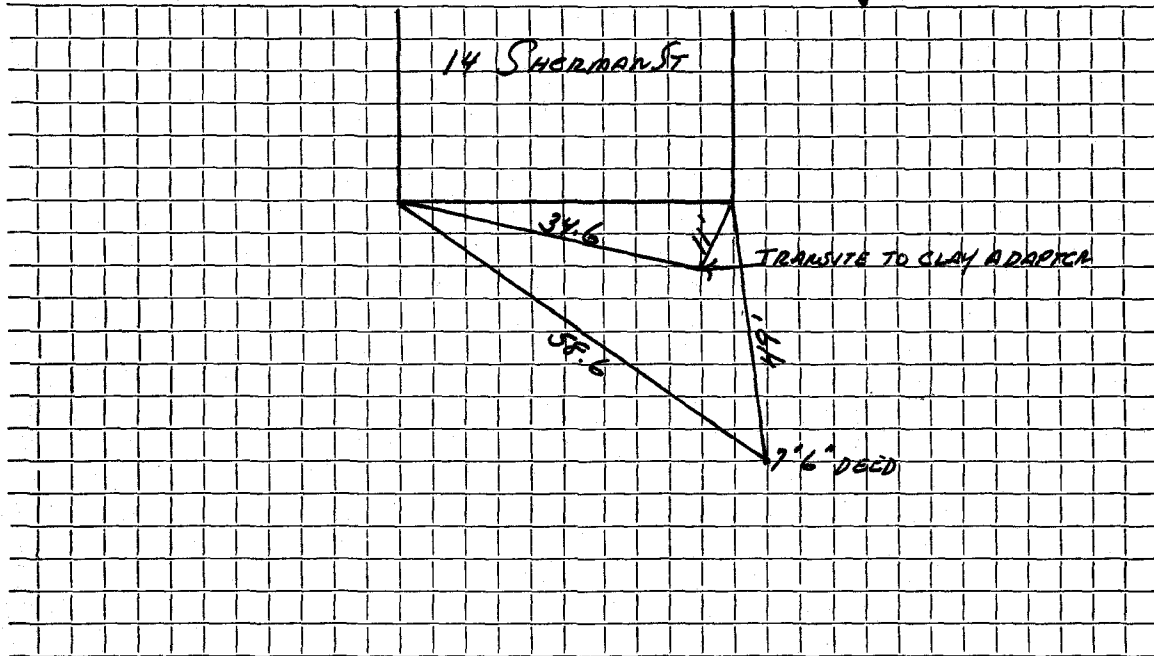

Connection made in Street. Work completed

Remarks:

.....
.....