

Name

Service No.

Address 15 Sherman Street

15 Sherman Street

Location

Kind of Pipe

Size 6"

Size of Main 8"

~~REPAIR~~ - Renewal - ~~NEW SERVICE~~ Valeri #3555

Location


Date	Material	Amount	Total	Date	Amount
11-20-80	5 1/2" Cast Iron				
	1 1" Nipple				
	1 6" Wye				
4-3-99	1-6x6 Clay to PVC Franco				
	1-6x6 AC to PVC Franco			2-1-99	Problem 70' from
	1 6" PVC				MH in driveway
	1- 6" 90° Elbow				can be flushed with myers
					take of fins for nozzle
				3-22-99	Can't get by 81'
					SERVICE RENEWED OUTSIDE 4-3-99

DATE _____

TOWN OF LEXINGTON — BOARD OF PUBLIC WORKS
SEWER DIVISION

Sketch of Service Here

15

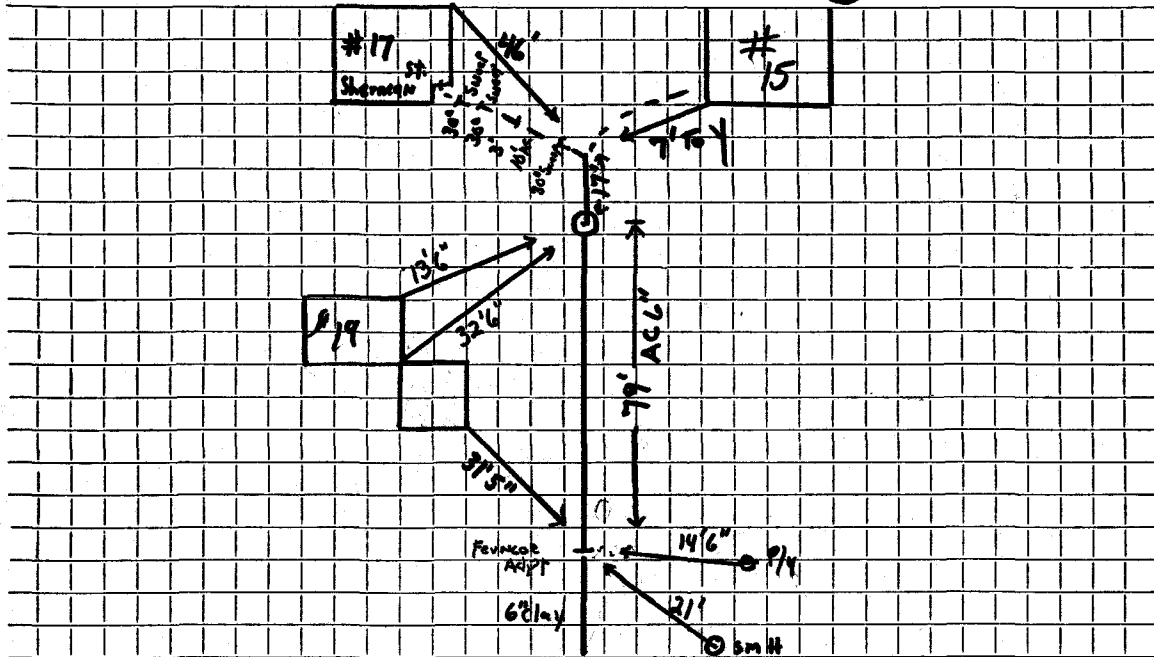

Connection made in Driveway..... Street No 17 Work completed

Remarks: 3-4" Iron pipe out of house.....

Service REPAIRED 4.3.99