




DATE \_\_\_\_\_

TOWN OF LEXINGTON — BOARD OF PUBLIC WORKS  
SEWER DIVISION

Sketch of Service Here

17

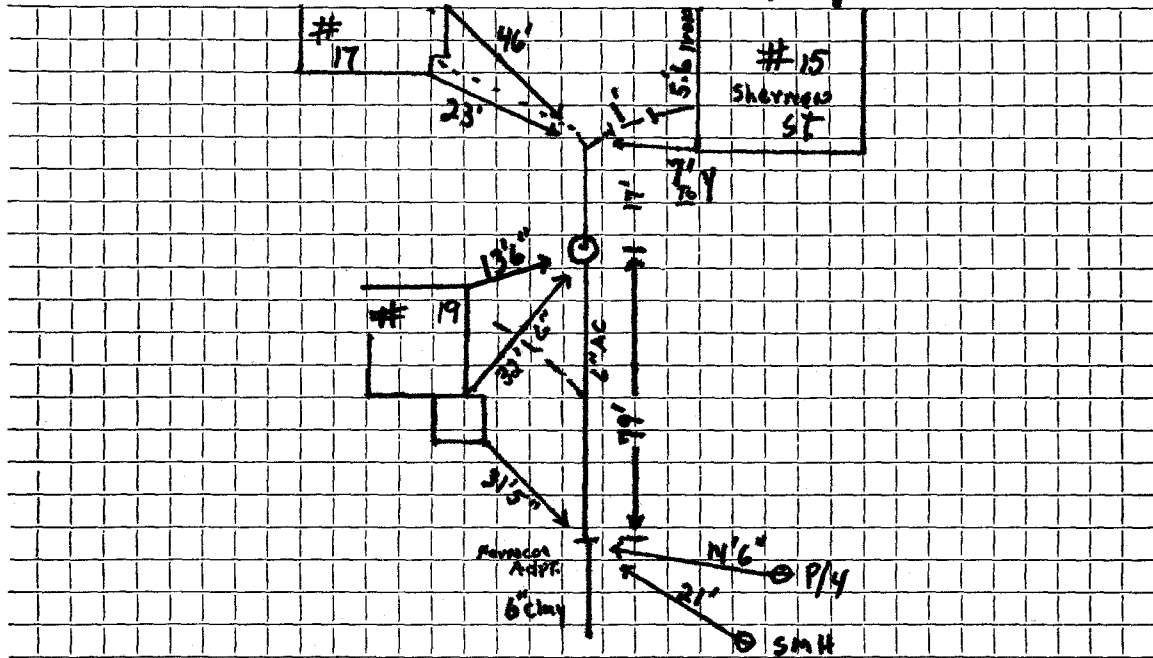

Connection made in Driveway 6" AC Street. Work completed 11-20-80

Remarks: No # 15 Sherman