




TOWN OF LEXINGTON — BOARD OF PUBLIC WORKS  
SEWER DIVISION

Sketch of Service Here

19

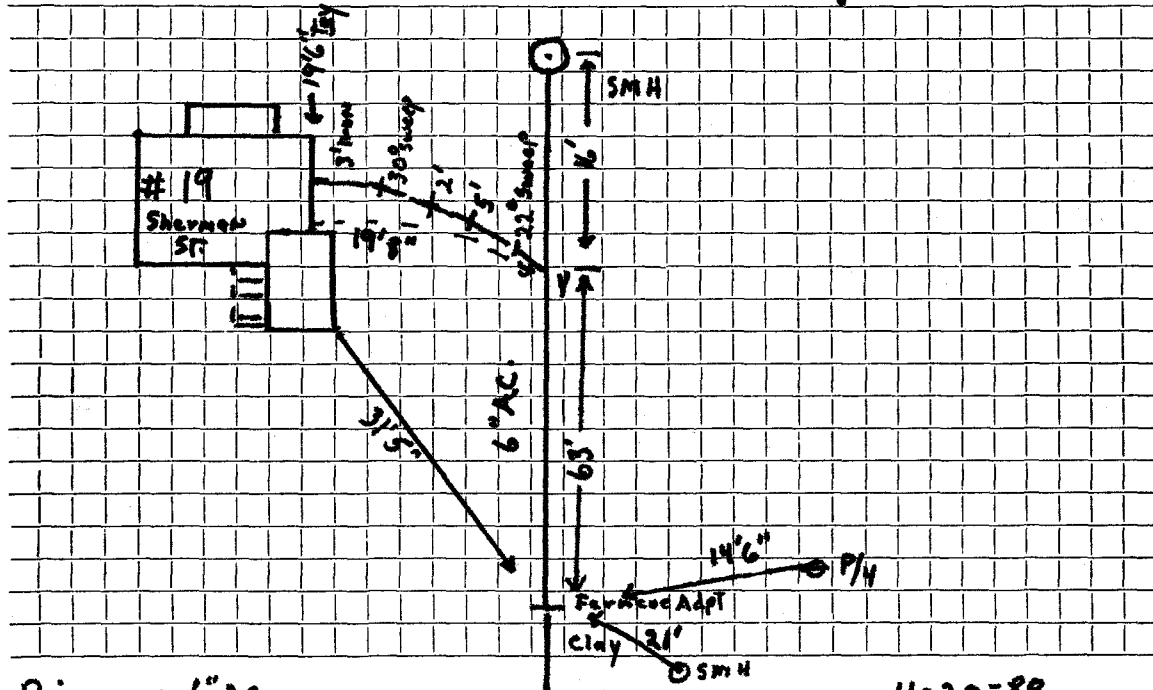

Connection made in Drive way 6" AC. Street. NO 19 Work completed 11-20-80

Remarks: .....

.....

.....