


DATE 3/23/04

TOWN OF LEXINGTON — BOARD OF PUBLIC WORKS
SEWER DIVISION

Sketch of Service Here

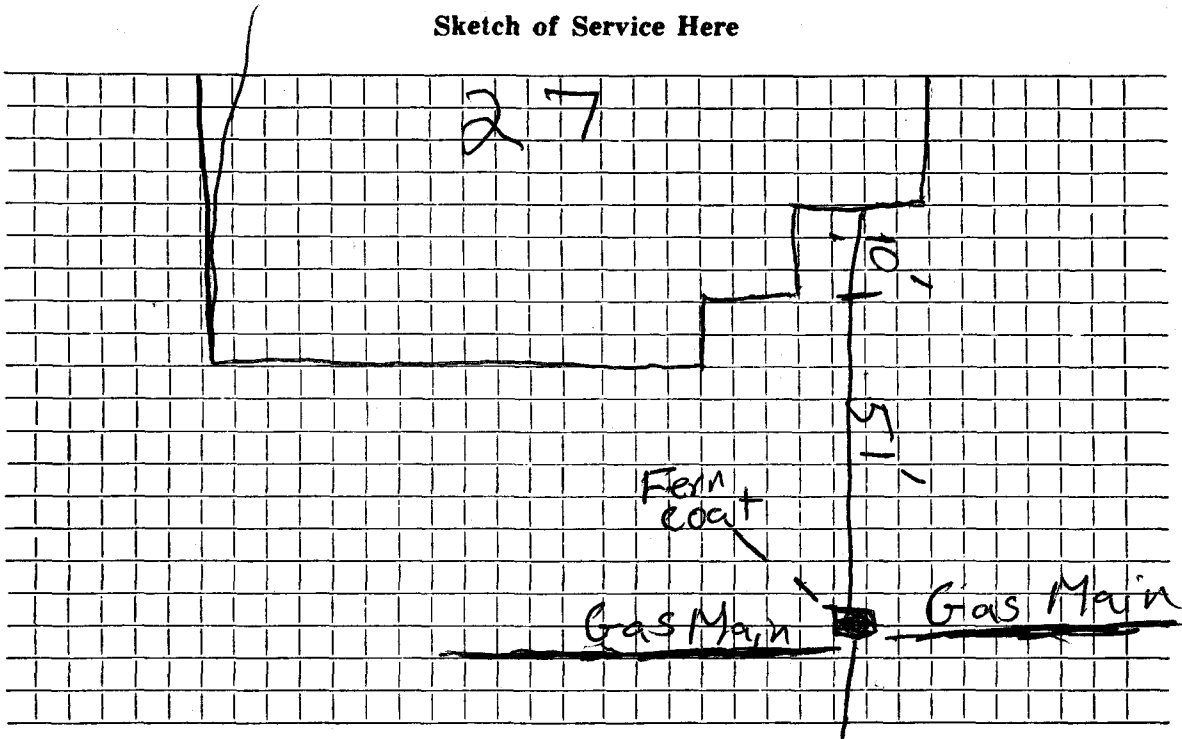

Connection made in Street. Work completed

Remarks: Clay on outside with Fibers at Joints
Fern Coat and Gas main 61' From Foundation.