

Name

Service No.

893

Address

31 Sherman St

31 Sherman Street

Location

31 Sherman Street

Kind of Pipe

Size 6"

Size of Main 8"

Repair—Renewal—New Service

Location

Hadley Press, Inc., Lexington

Date

Material

Amount

Total

Date

Amount

Labor

TOWN OF LEXINGTON—BOARD OF PUBLIC WORKS  
SEWER DIVISION

DATE \_\_\_\_\_

NO. \_\_\_\_\_

The undersigned applies for the construction of a particular sewer connecting No. 31 Sherman St Street and hereby agrees to comply with the Rules and Regulations governing the construction and use of Particular Sewers, as now or at any future time established by the Board of Selectmen.


Am't. of Estimate \$ \_\_\_\_\_

Am't. Paid \$ \_\_\_\_\_

\_\_\_\_\_  
Owner

Sketch of Service Here

**31**

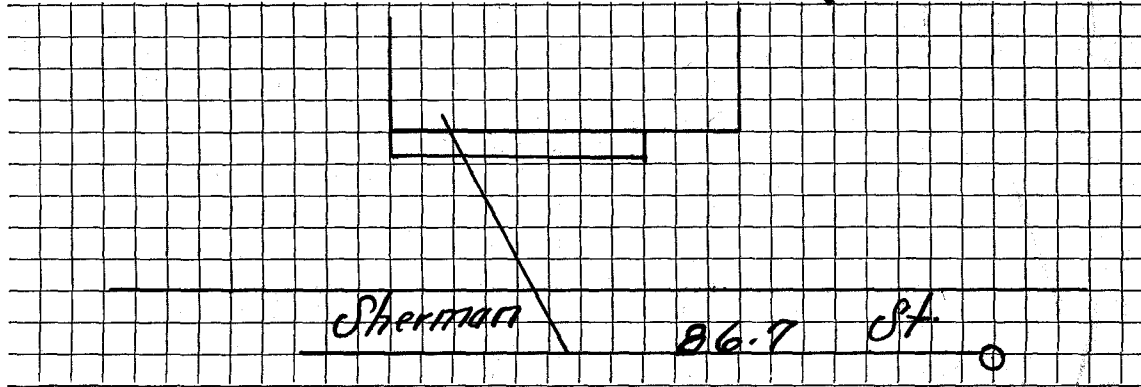

Connection made in \_\_\_\_\_ Street.

Work completed \_\_\_\_\_ 19

Remarks: