


DATE _____

TOWN OF LEXINGTON — BOARD OF PUBLIC WORKS
SEWER DIVISION

Sketch of Service Here

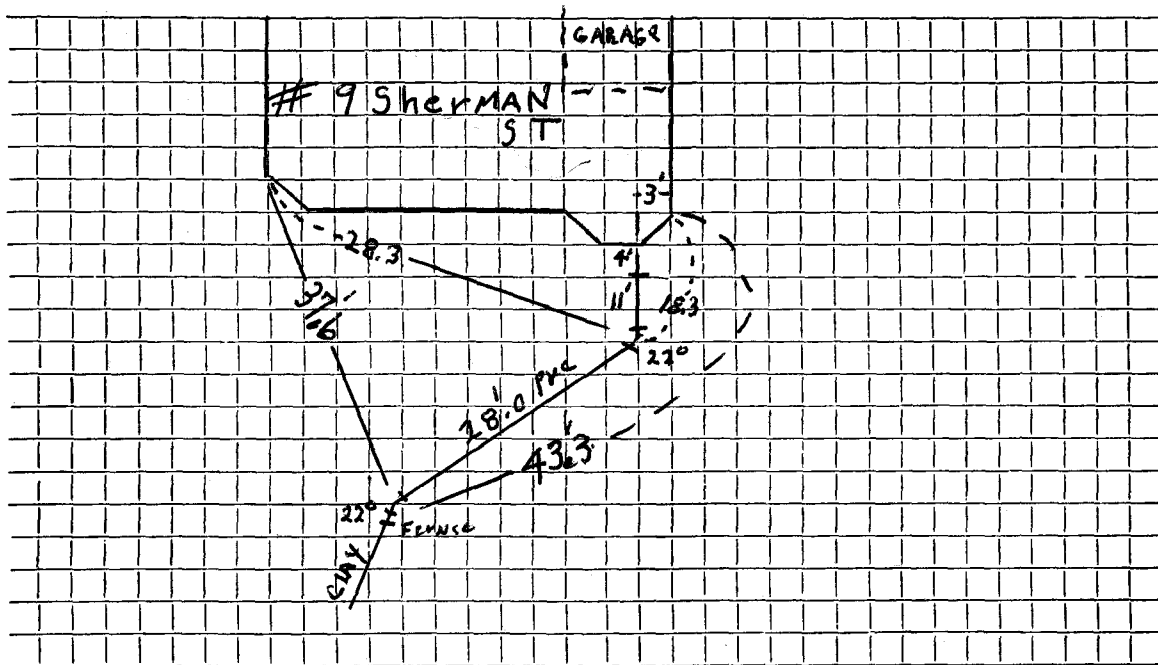

Connection made in Street.

Work completed .. 11/2/04 .. J. McLaughlin.

Remarks:
.....
.....