

Name Eugene H. Partridge

Service No. 22 896

Address 12 Shirley St., Lexington

12 Shirley Street Location 12 Shirley St.

Kind of Pipe

Size 6"

Size of Main 8"

~~Repair - Renewal -~~ New Service

Location

Date		Material	Amount	Total	Date	Amount
11/8/33	20	Hrs. Labor @.50	10 00			
<sup>7</sup> 86.93	53	" " @.55	29 15		Cect. 30 1933 - Cash	20 -
11-21-33	15	" " @.60	9 00	\$48 15	Rec. 28 1933 - "	56 93
		10% Overhead		4 81		
	36'	6" Sewer Pipe @.15	5 40			
	10'	4" Iron Pipe @.40	4 00		10/3/01	REPAIR UNDER GAS
		Sulphur & Jute	1 44		MAIN	48" PVC
		Trucking	75			
	25	Sticks Dyn. @ .20	5 00			
	17	Caps @ .14	2 38	18 97		
	6	Hrs. Comp. @ 2.50		15 00		
				\$86 93		86 93
		Labor				

Hadley Press, Inc., Lexington

TOWN OF LEXINGTON—BOARD OF PUBLIC WORKS

**SEWER DIVISION**

DATE October 30, 1933.

NO. \_\_\_\_\_


The undersigned applies for the construction of a particular sewer connecting No. 2 Shirley St. Street and hereby agrees to comply with the Rules and Regulations governing the construction and use of Particular Sewers, as now or at any future time established by the Board of Selectmen.

Am't. of Estimate \$ \_\_\_\_\_

Am't. Paid \$ 30

Eugene H. Purditt Owner

Sketch of Service Here

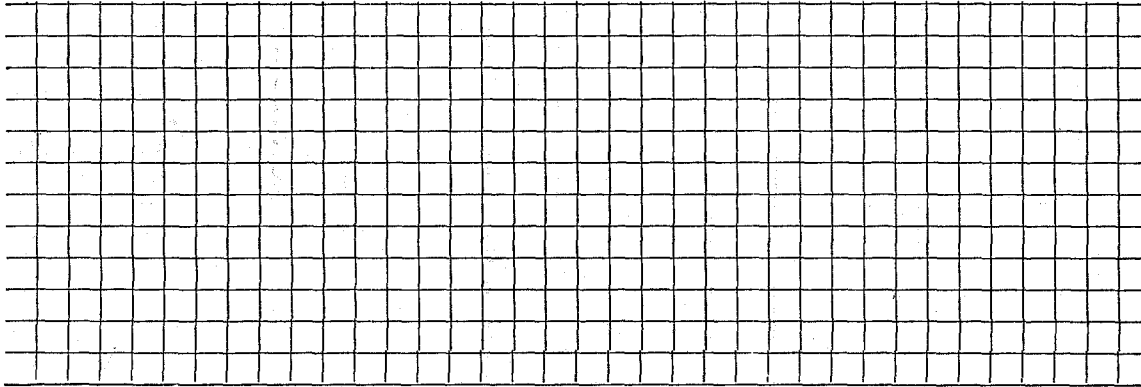

Connection made in \_\_\_\_\_ Street.

Work completed \_\_\_\_\_ 19

Remarks: