

Name

Service No.

Address 19 - 21 Shirley Street

Service No.

19-21 Shirley Street

Location

Kind of Pipe

Size 6" Location

Size of Main 8"

~~Repair~~ - Renewal - ~~New Service~~

Location


Date	Material	Amount	Total	Date		Amount
3-22-45						
	32' 6" V.C. Pipe					
	5' 4" Soil Pipe					
					OUTSIDE	
				9/10/86	24' 6" PVC	
					1 4" Rubber Donut	
					1 PVC 6 x 6 Fernco	
					1 PVC to AC 6 x 6 Fernco ✓	
				7-11-79		
					10' 6" Transite	
					5' 6" Nipple	
					1' 6" Nipple	
					1 6"-11 $\frac{1}{4}$ " Elbow	
					1 6" Clay-Transite Adapter	

DATE _____

TOWN OF LEXINGTON — BOARD OF PUBLIC WORKS

SEWER DIVISION

Sketch of Service Here **19-21**

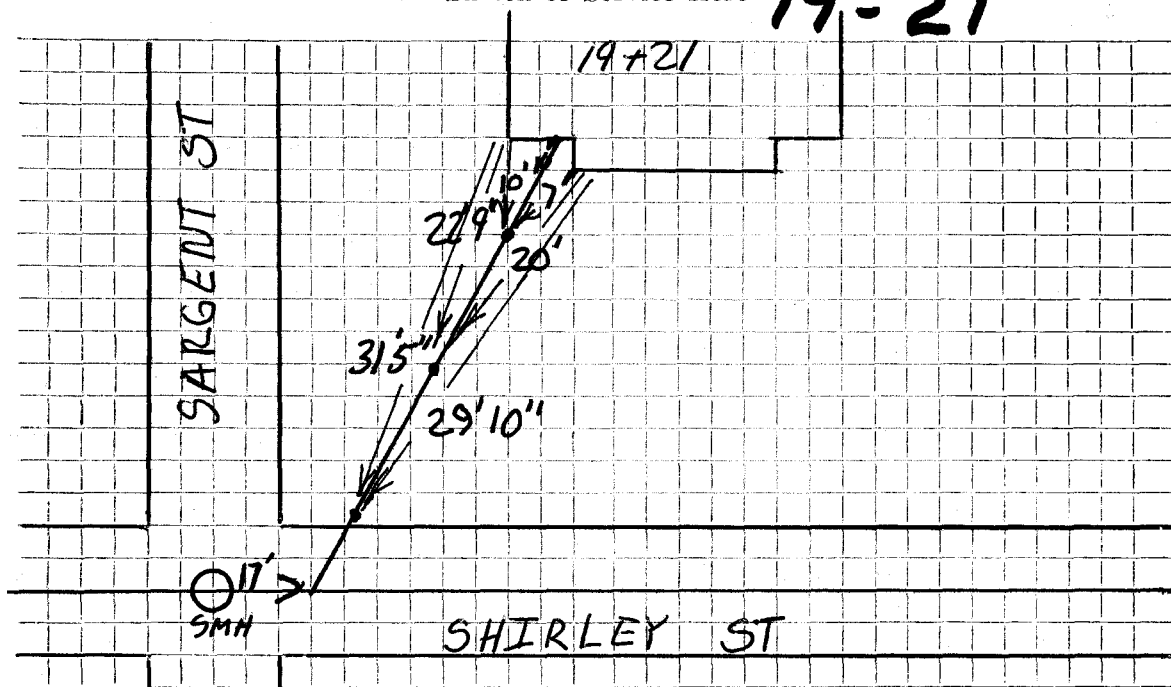

Connection made in Street. Work completed

Remarks: