

Name Theodore Martin

Service No.

Address 20 SHIRLEY ST.

20 Shirley Street

Location

Kind of Pipe

Size 6"

Size of Main 8 "

Repair ← **Renewal** → **New Service**

Kirkland #0309

Location


DATE 1/6/94

TOWN OF LEXINGTON — BOARD OF PUBLIC WORKS

SEWER DIVISION

Sketch of Service Here

20

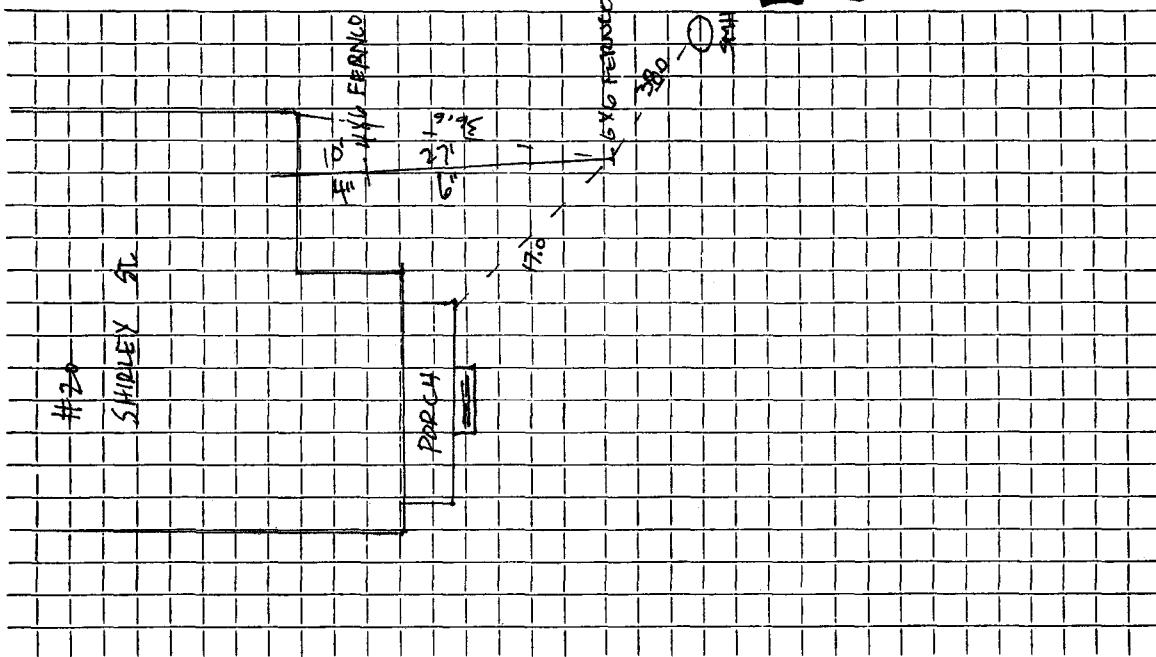

Connection made in Street.

Work completed 12/3/93.....KIRKLAND & SHAW.....

Remarks: