




DATE 8/4/94

TOWN OF LEXINGTON — BOARD OF PUBLIC WORKS  
SEWER DIVISION

Sketch of Service Here

24

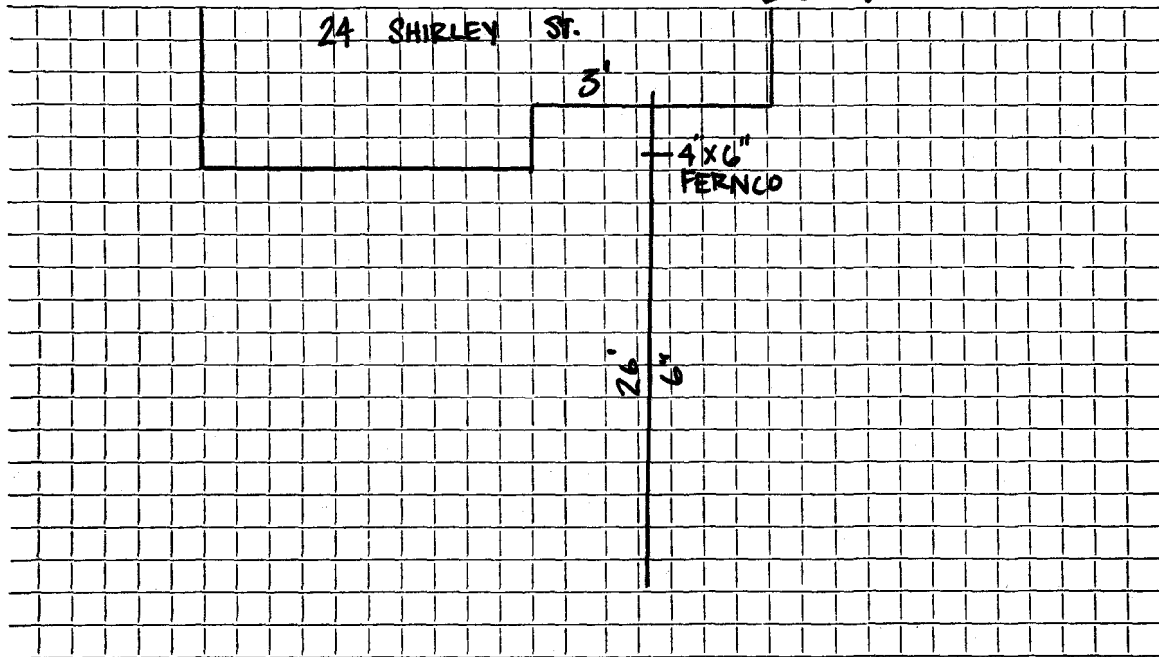

Connection made in ..... Street. Work completed .....

Remarks: Original Service 7-19-30 .....