


DATE _____

TOWN OF LEXINGTON — BOARD OF PUBLIC WORKS

SEWER DIVISION

Sketch of Service Here

27

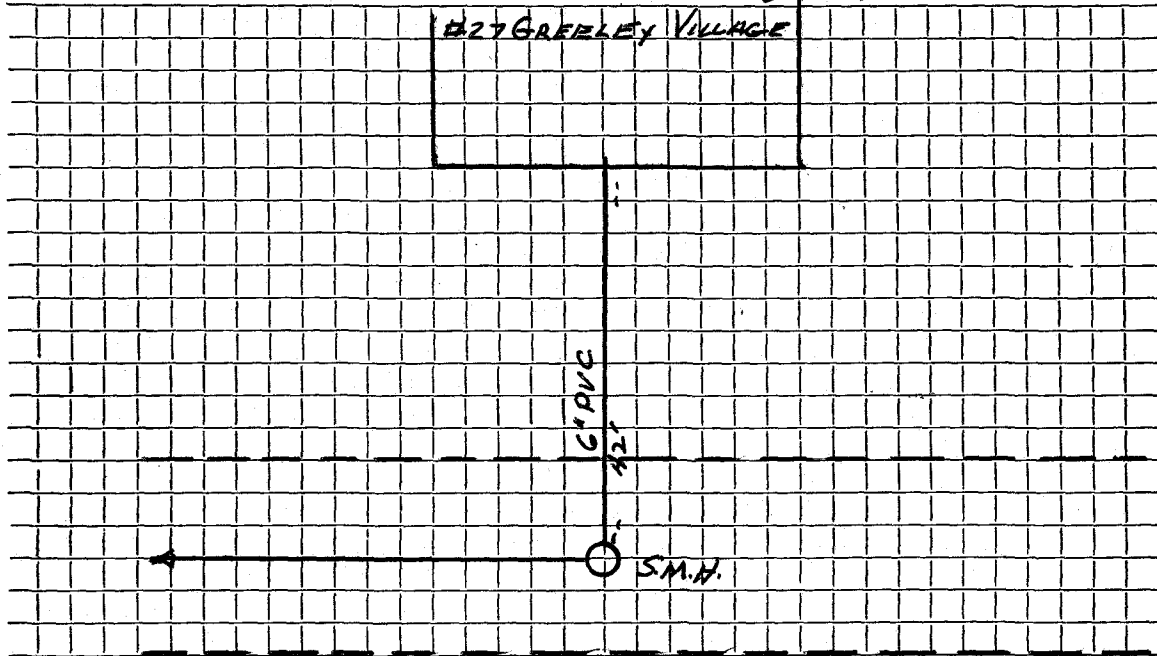

Connection made in Street. Work completed 6/30/88

Remarks:

.....

.....