

Name William O'Leary

Service No. ~~11~~ A 906Address ³⁶ Shirley Street, Lexington

36 Shirley Street Location 36 Shirley St

Kind of Pipe

Size 6"

Size of Main 8"

~~Repair-Replace~~ New Service

Location

Date	Material	Amount	Total	Date	Amount
1935					
June 25	24 hrs. @ 55¢	13 20		This deposit taken care of in one deposit of \$81.00	
	14 " @ 60¢	8 40			
	10% Overhead on labor	<u>2 16</u>	23 76		
	66' 6" S.Pipe @ 20¢		13 20		
	Sulphur & Jute		75		
	Trucking 2 hrs. @ 1.50		3 00		
	Compressor 1 hr.		<u>2 50</u>		
			43 21		
		12.400		Repair made " service hit by gas company	
	Labor				
				2'-6x6 PVC to Clay Ferricos	
				2'-6" PVC pipe	

TOWN OF LEXINGTON—BOARD OF PUBLIC WORKS

SEWER DIVISION


DATE 6-14-35

The undersigned applies for the construction of a particular sewer connecting No. 36 Shirley St. Street and hereby agrees to comply with the Rules and Regulations governing the construction and use of Particular Sewers, as now or at any future time established by the Board of Selectmen.

Am't. of Estimate \$ ~~81.00~~ for a house

Am't. Paid \$ 50.00

William C O Leary Owner

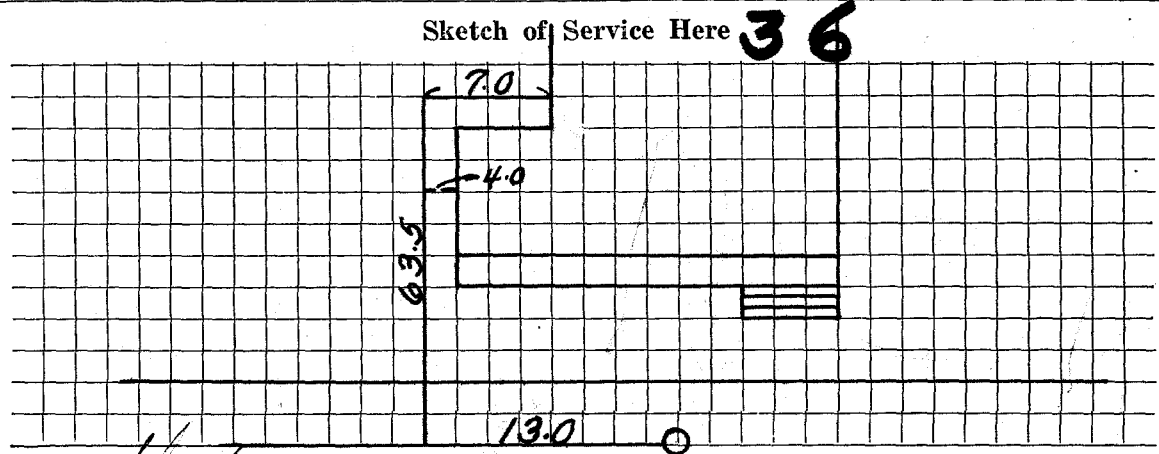

Connection made in Shirley Street.

Work completed _____ 19

Remarks: Owner to do own digging to street line