

Bill to: **Custance Bros.**

Service No. **6**

894

Address **Lexington, Mass.**

7 Shirley St.

Location **7 Shirley Street**

Kind of Pipe

Size **6"**

Size of Main **8"**

Repair—Renewal—New Service

Location

Date	Material	Amount	Total	Date	Amount
May 7, 1940	Labor: 16 hrs. @ 55¢	8 80		June 6, 1940	Paid 58 99
May 5/20/40	33 hrs. @ 60¢	19 80			
	4 " @ 70¢	2 80	31 40		
	10% Overhead		3 14		
	39' 6" Sewer Pipe @ 16¢		6 24		
	1 6" 1/8 Bend		65		
	Jointing compound		2 40		
	Compressor, 1 hr.		3 00		
	Trench repairs		10 66	Bill sent 6/16/40	
	Trucking, 2 hrs. @ 75¢		1 50		
			58 99		
	Labor			6/1/68	Proto
				1-22-73	Proto 40' out

Hadley Press, Inc., Lexington

TOWN OF LEXINGTON—BOARD OF PUBLIC WORKS
SEWER DIVISION

DATE _____

NO. _____

The undersigned applies for the construction of a particular sewer connecting No. 7 Shirley St.,
Street and hereby agrees to comply with the Rules and Regulations governing the construction and use of Particular
Sewers, as now or at any future time established by the Board of Selectmen.

Am't. of Estimate \$ _____


Am't. Paid \$ _____

Custance Bros.

~~OWNER~~

Sketch of Service Here

7

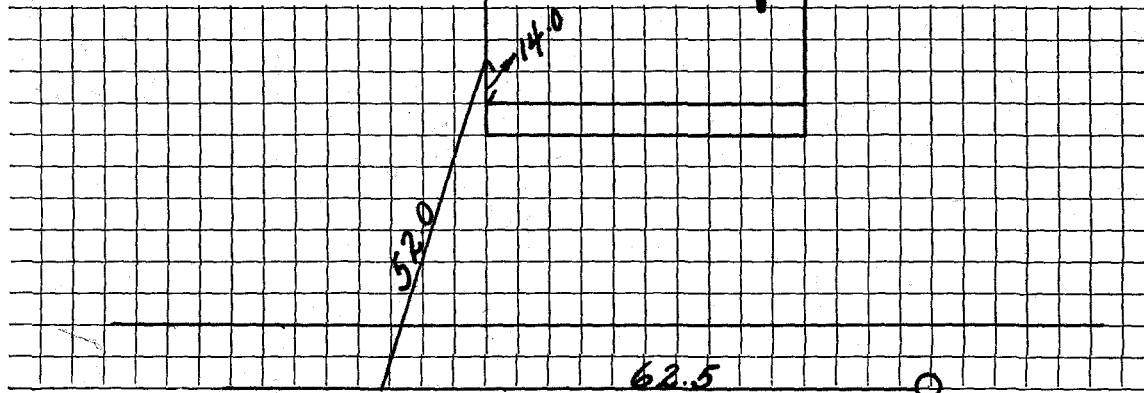

Connection made in _____ Street.

Work completed _____ 19

Remarks: