

Name **Annie J. Burke**

Service No. **24 895**

Address ~~Bedford Street & Shirley St.~~

9+11 Shirley St. Location **9+11 Shirley St.**

Kind of Pipe

Size **6"**

Size of Main **8"**

~~Repair~~ ~~Renewal~~ ~~New Service~~

Location

Date	Material	Amount	Total	Date	Amount
1/21/34	50 Hrs. Labor @ .55	\$27 50			
1-27-31	6 " " @ .60	3 60	\$31 10	Nov. 13 1934 - Deposit	44 33
2-14-32	10% Overhead		3 11		
to Russell	22' 6" S. Pipe @ .15	3 30			
	5' 4" Iron Pipe @ .50	2 50			
	1 1/8" Bend	70			
	Trucking-3Hrs. @ .75	2 25			
	Sulphur & Jute	88	10 13		
			\$44 33		
	2-16-06 Repair				
	Labor				
	3'-6" PVC				
	2-6x6 PVC to Clay FRANKOS				

Hadley Press, Inc., Lexington

TOWN OF LEXINGTON—BOARD OF PUBLIC WORKS

SEWER DIVISION

DATE Sept. 22, 1934

NO. _____


The undersigned applies for the construction of a particular sewer connecting No. 1 Shirley Street Street and hereby agrees to comply with the Rules and Regulations governing the construction and use of Particular Sewers, as now or at any future time established by the Board of Selectmen.

Am't. of Estimate \$ _____

Am't. Paid \$ _____

Anno J Burke Owner
by Francis C Burke

Sketch of Service Here

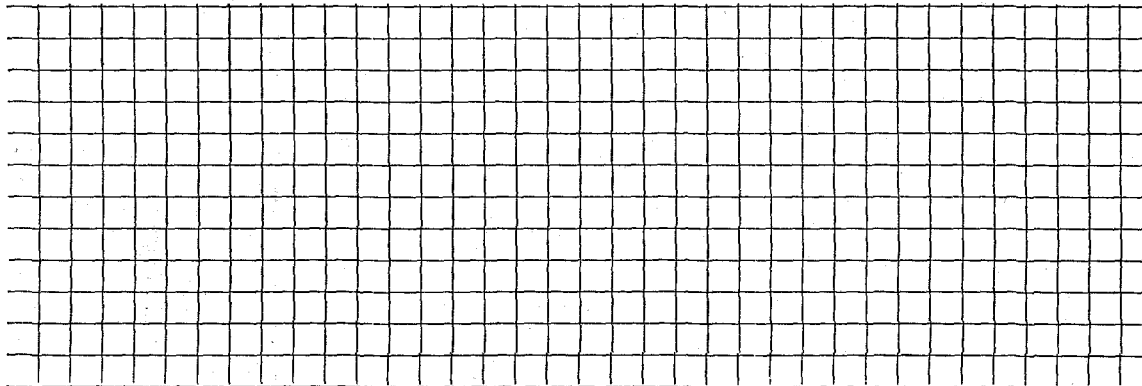

Connection made in _____ Street. Work completed _____ 19

Remarks:

Repair made in sidewalk
- under GAS SERVICE