

Name Lexington Housing Authority Bldg. #10

Service No. \_\_\_\_\_

Address Shirley Street

Location \_\_\_\_\_

Kind of Pipe \_\_\_\_\_

Size 6"

Size of Main 8"

Repair—Renewal—New Service Concrete Const. Co. #1073

Location \_\_\_\_\_


Date	Material	Amount	Total	Date	Amount
5/21/68	132.51 3 6" Transite pipe				

DATE \_\_\_\_\_

TOWN OF LEXINGTON — BOARD OF PUBLIC WORKS

SEWER DIVISION

Sketch of Service Here  
*Building #10*

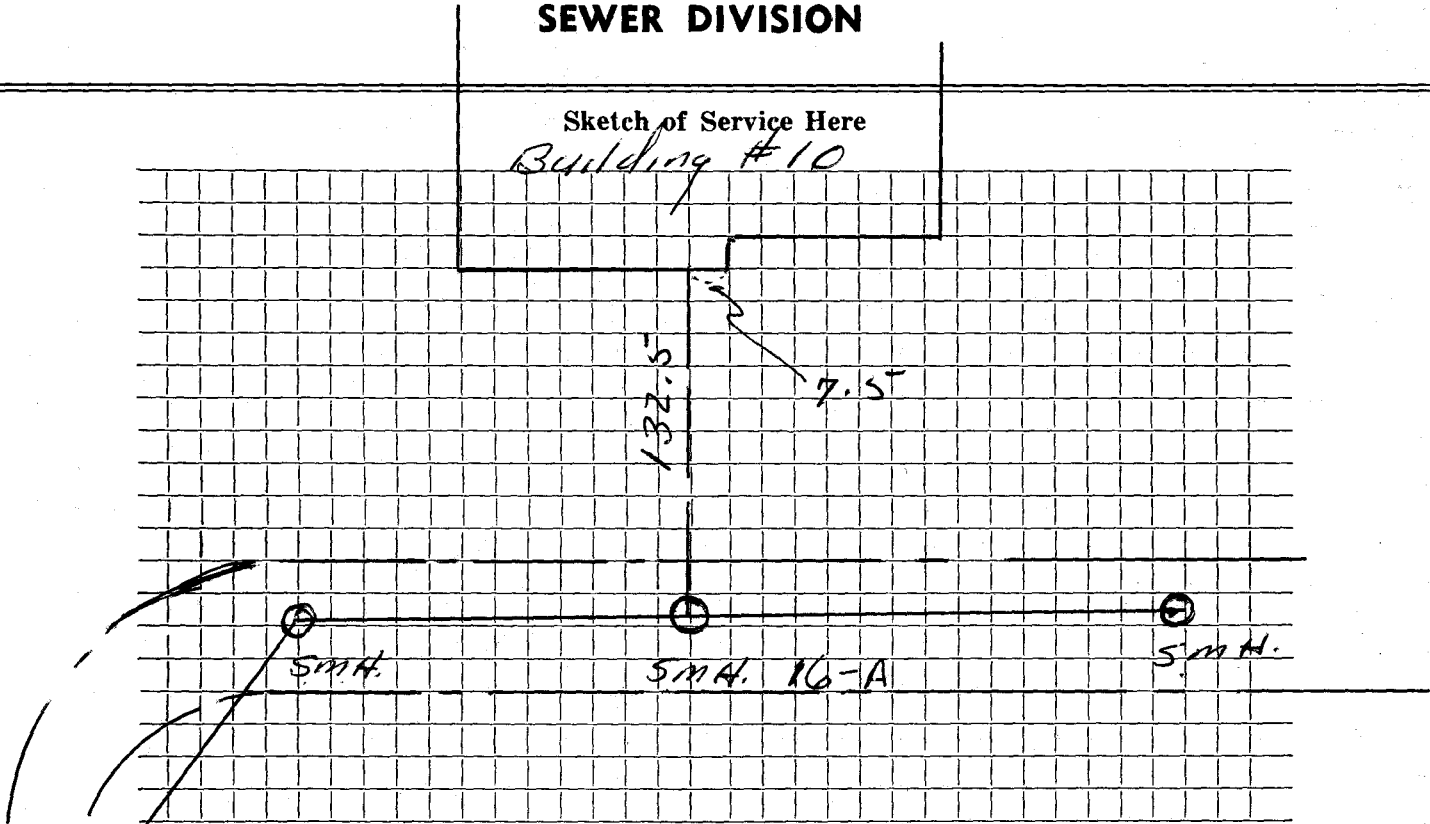

Connection made in ..... Street. Work completed .....

Remarks: .....  
.....  
.....