

Name Lexington Housing Authority Bldg. #13

Service No.

Address Shirley Street

Location

Kind of Pipe

Size 6"

Size of Main 8"

Repair—Renewal—New Service Concrete Const. Co. #1075

Location


| Date | | Material | Amount | | Total | | Date | | Amount | |
|--------|------|------------------|--------|--|-------|--|------|--|--------|--|
| 7/2/68 | 8.5' | 6" Transite pipe | | | | | | | | |
| | | | | | | | | | | |
| | | | | | | | | | | |
DATE _____

TOWN OF LEXINGTON — BOARD OF PUBLIC WORKS

SEWER DIVISION

Sketch of Service Here
Building # 13

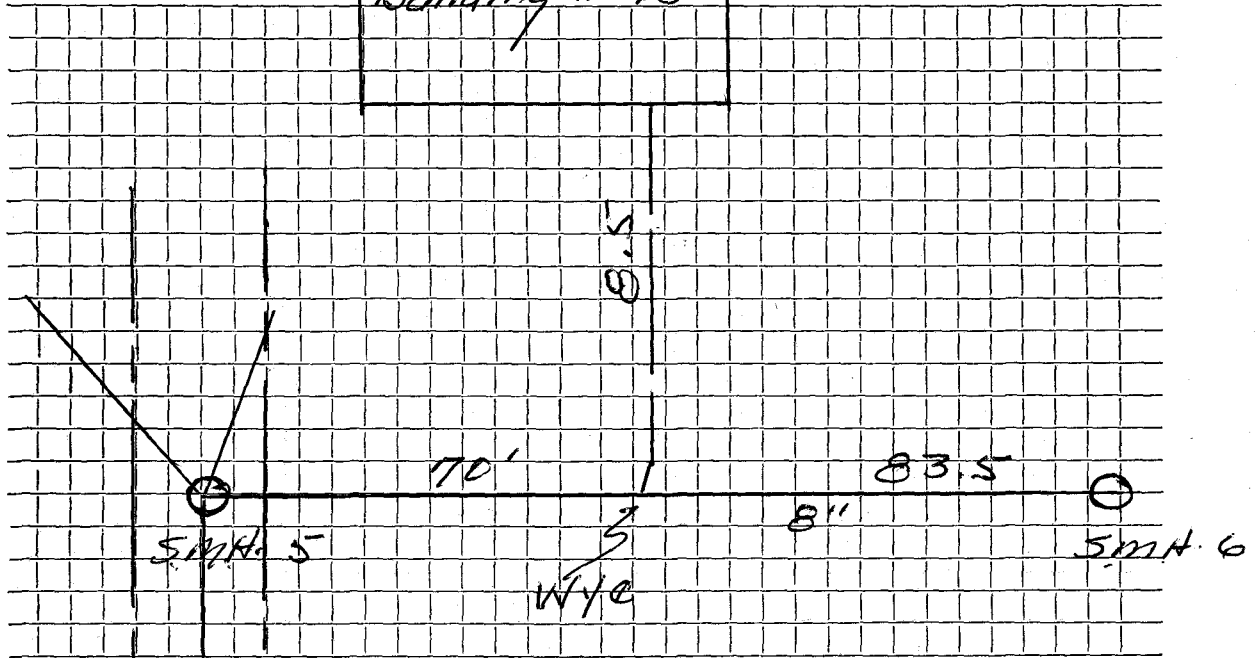

Connection made in Street. Work completed

Remarks:

.....
.....