

Name Lexington Housing Authority Bldg. #16

Service No.

Address Shirley Street

Location

Kind of Pipe

Size 6"

Size of Main 8"

Repair—Renewal—New Service Concrete Const. #1077


Location

Date		Material	Amount		Total		Date		Amount	
7/1/68	15.5'	6" Transite pipe								

DATE _____

TOWN OF LEXINGTON — BOARD OF PUBLIC WORKS

SEWER DIVISION

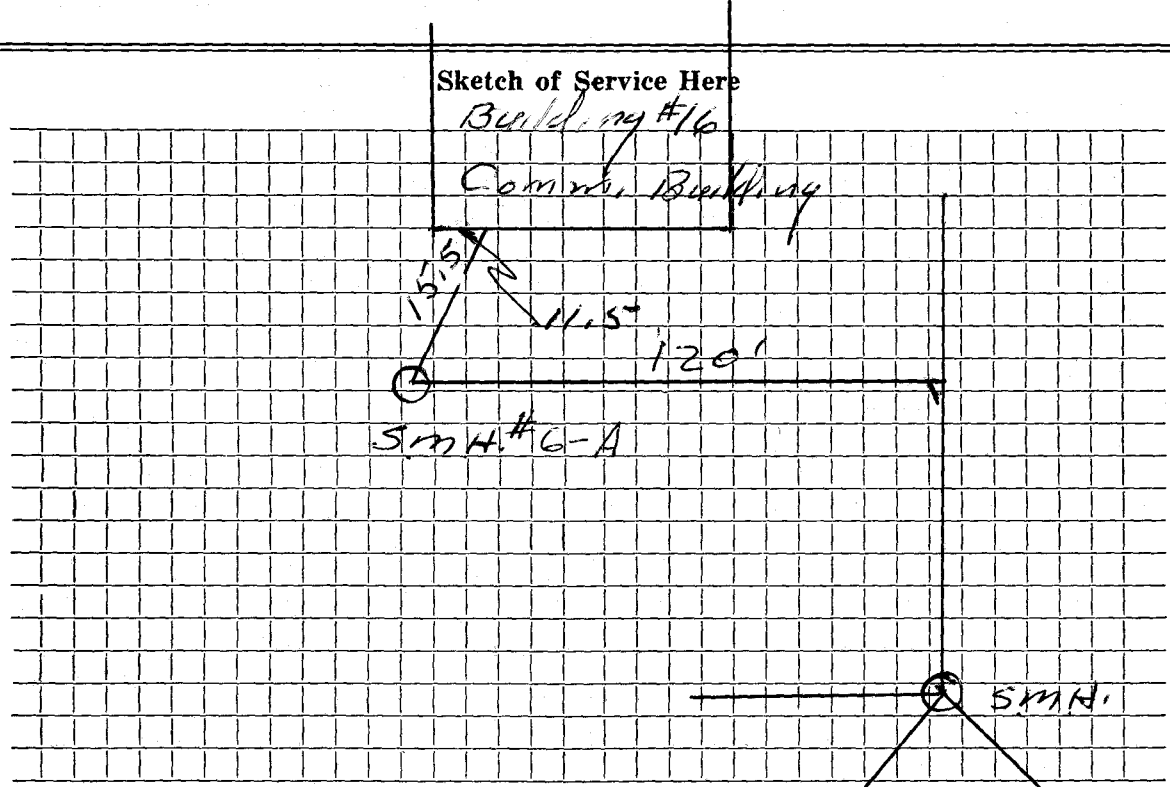

Connection made in Street. Work completed

Remarks:
.....
.....