

Name Lexington Housing Authority Bldg. #18

Service No.

Address Shirley Street

Location

Kind of Pipe

Size 6"

Size of Main 8"

Repair—Renewal—New Service Concrete Const. Co. #1079


Location

Date		Material	Amount		Total		Date		Amount	
5/27/68	22'	6" Transite pipe								

DATE _____

TOWN OF LEXINGTON — BOARD OF PUBLIC WORKS

SEWER DIVISION

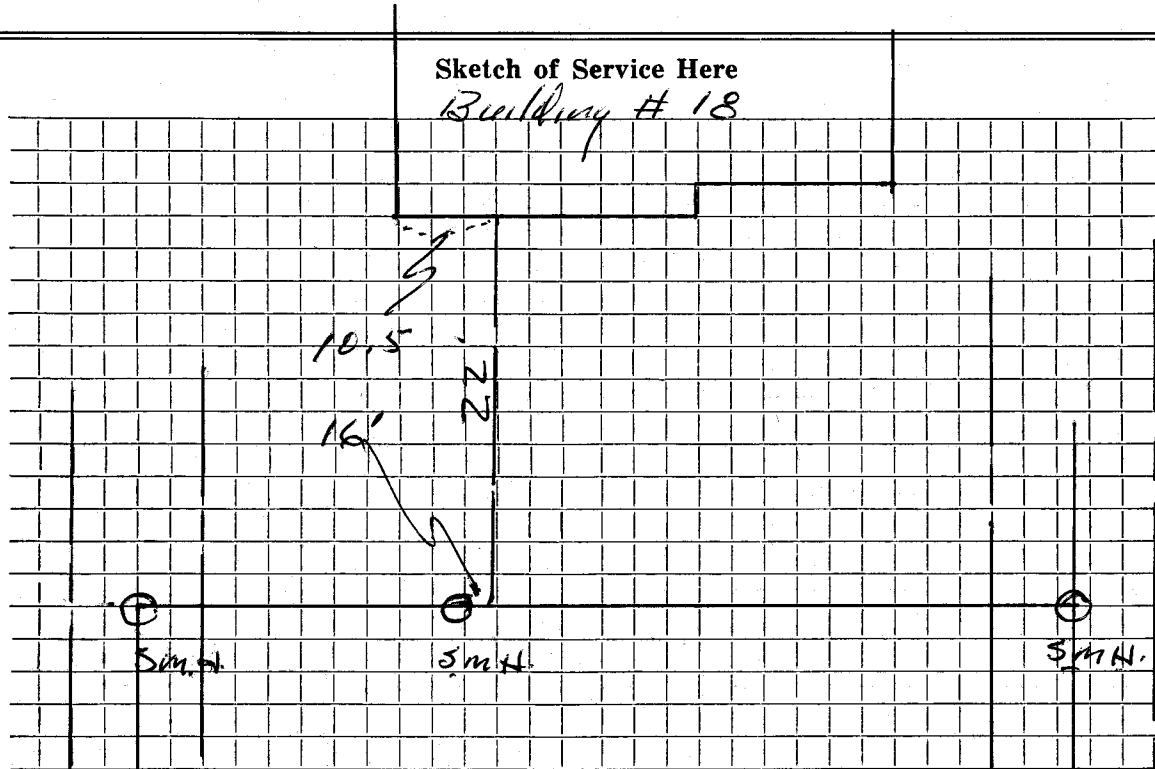

Connection made in Street. Work completed

Remarks:

.....

.....