

Name Lexington Housington Authority Bldg. #23

Service No.

Address Shirley Street

Location

Kind of Pipe

Size 6"

Size of Main 8"

Repair—Renewal—New Service Concrete Const. #1081

Location


Date	Material	Amount	Total	Date	Amount
6/22/68	63.5' 6" Transite pipe				

DATE \_\_\_\_\_

TOWN OF LEXINGTON — BOARD OF PUBLIC WORKS

SEWER DIVISION

Sketch of Service Here  
Building # 23

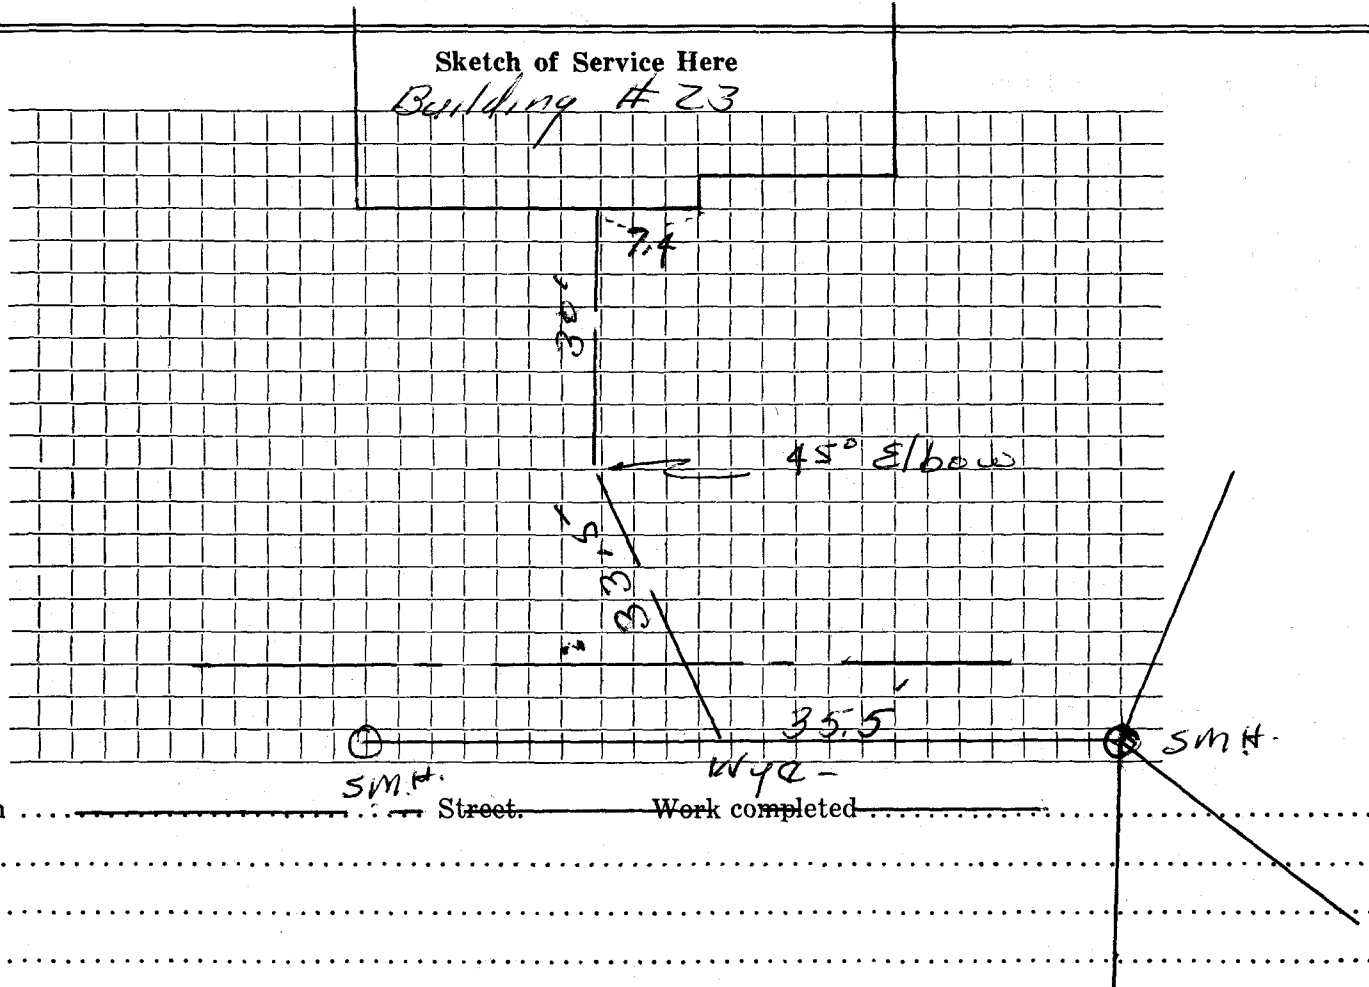

Connection made in ..... Street. Work completed .....

Remarks: .....  
.....  
.....