

DATE _____


TOWN OF LEXINGTON — BOARD OF PUBLIC WORKS

SEWER DIVISION

Sketch of Service Here

Building #25-1

SCR. FOR #26

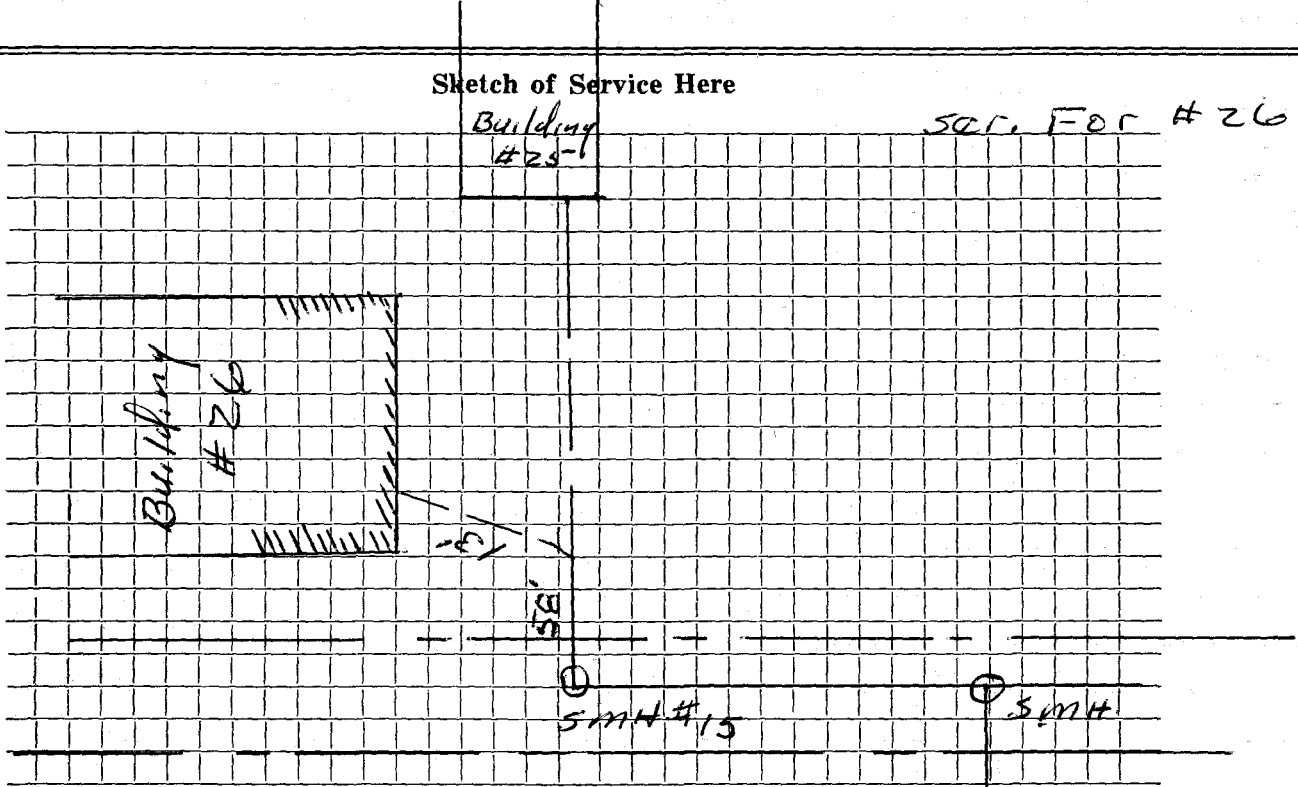

Connection made in Street. Work completed

Remarks:
.....
.....