

Name Lexington Housing Authority Bldg. #8

Service No.

Address Shirley Street

Location

Kind of Pipe

Size 6"

Size of Main 8"

Repair—Renewal—New Service Concrete Const. Co. #1072


Location

Date		Material	Amount	Total	Date		Amount
1/23/68	55.3	6" Transite pipe					

DATE _____

TOWN OF LEXINGTON — BOARD OF PUBLIC WORKS

SEWER DIVISION

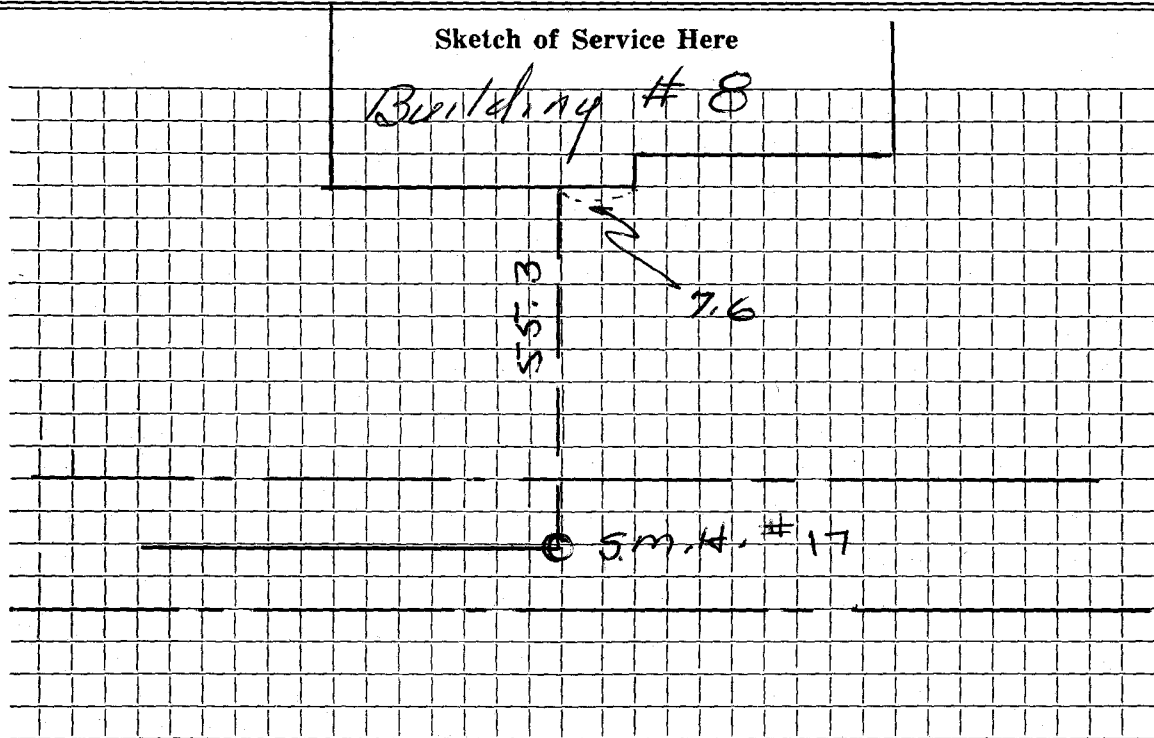

Connection made in Street. Work completed

Remarks:
.....
.....