

Name Lexington Housing Authority Bldg. #2

Service No.

Address Shirley Street

Location

Kind of Pipe

Size 6"

Size of Main 8"

Repair—Renewal—New Service Concrete Const. Co. #


Location

Date		Material	Amount		Total		Date				Amount	
12/2/68	82.5	Transite pipe										

DATE _____

TOWN OF LEXINGTON — BOARD OF PUBLIC WORKS

SEWER DIVISION

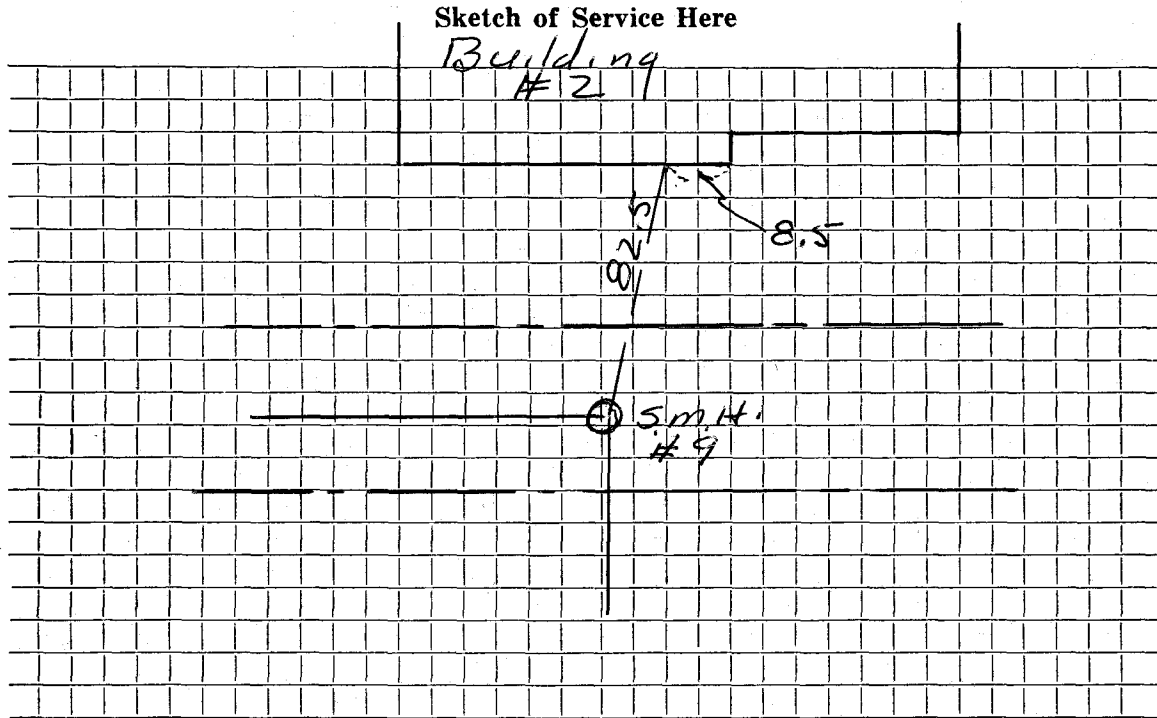

Connection made in Street. Work completed

Remarks:

.....

.....